

Lincoln
06
7-67
CODED

MISSISSIPPI
BOARD OF WATER COMMISSIONERS
416 North State Street
Jackson, Mississippi 39201

WATER WELL DRILLERS LOG

July 7, 1967 date well completed
L. L. Loperford Water Well firm name
Lincoln county well located

LANDOWNER: Calvin P. Barksdale
Rt 3 Box 425 Smithdale Miss
(mailing address)


WELL LOCATION:
sec 5 T 5 N R 6 E S W
10 8 miles NW of Sumner
(distance) (direction) (nearest town)

WELL PURPOSE: home
(home, irrigation, municipal, industrial)

- WELL COMPLETION DATA:
- (1) diameter (inches) 4 1/2
 - (2) total depth (feet) 93
 - (3) static water level (feet) 79 below above top of ground.
 - (4) casing plastic 87
(material) (depth)
 - 4 if telescope see back.
(size)
 - (5) screen 61 87
(length) (depth to top)
 - 4 plastic
(size) (material)
 - (6) pump _____
(HP) (yield gpm)
 - _____ (type power)
 - (7) electric log no
(yes or no)
 - _____ (organization running log)
 - (8) how well bottom plugged reloud peg

Description of formations encountered	from	to
top soil	0	12
pkd sand	12	38
sand & gravel	38	60
Red Chalk	60	67
coarse sand	67	85
coarse sand & gravel	85	93


CODED

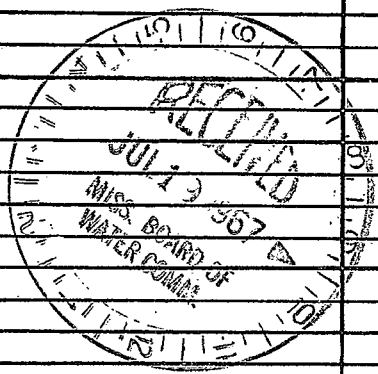

DRILLERS REMARKS:

If well telescopes please sketch and show depths.

GROUND LEVEL

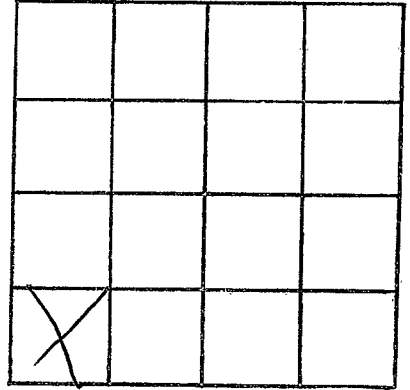

SECTION 8

Please indicate well location X.

ADDITIONAL INFORMATION

If more than one screen,
show locations of each on sketch.