

Lincoln
07
8-67

MISSISSIPPI
BOARD OF WATER COMMISSIONERS
416 North State Street
Jackson, Mississippi 39201

WATER WELL DRILLERS LOG

8-7 1967 *Everard W W & S Lincoln*
date well completed firm name county well located

LANDOWNER: *OWIS Woodall*
RT 3 Box 20
Bogue Chitto
(mailing address)


description of formations encountered	from	to
<i>Top soil + clay</i>	<i>0</i>	<i>12</i>
<i>Sand</i>	<i>12</i>	<i>92</i>
<i>gravel + sand</i>	<i>92</i>	<i>100</i>

WELL LOCATION:
sect *25* T *5* N *6* E *6* W
12 miles *W* of *Bogue Chitto*
(distance) (direction) (nearest town)

WELL PURPOSE: *Home*
(home, irrigation, municipal, industrial)

- WELL COMPLETION DATA:
- (1) diameter (inches) *4*
 - (2) total depth (feet) *100*
 - (3) static water level (feet) *100* below top of ground.
 - (4) casing *plastic* *94*
(material) (depth)
4 (size) if telescope see back.
 - (5) screen *6'* *94*
(length) (depth to top)
4 (size) *plastic* (material)
 - (6) pump *1/2* - *Set* *79 gpm*
(HP) (yield gpm)
Elec (type power)
 - (7) electric log *No*
(yes or no)
 - (8) how well bottom plugged *Wood peg*


CODED

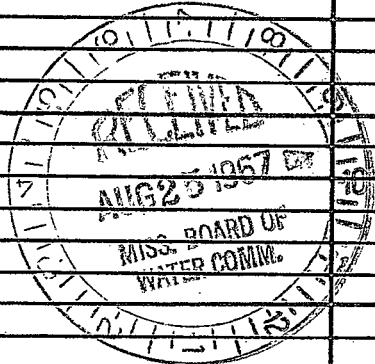

DRILLERS REMARKS:

If well telescopes please
sketch and show depths.

GROUND LEVEL

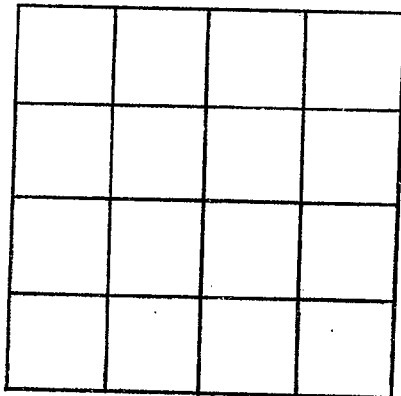

SECTION 25

Please indicate well location X.

ADDITIONAL INFORMATION

If more than one screen,
show locations of each on sketch.