

LINCOLN
 10
 5-68 CODED

MISSISSIPPI
 BOARD OF WATER COMMISSIONERS
 416 North State Street
 Jackson, Mississippi 39201

WATER WELL DRILLERS LOG

5-31 1968 Fitzgould well shw @ Lincoln
 date well completed firm name county well located

LANDOWNER: Curtis upkins
R.R. Summit, Miss.
 (mailing address)


description of formations encountered	from	to
<u>Red clay</u>	<u>0</u>	<u>15</u>
<u>Red sand</u>	<u>15</u>	<u>60</u>
<u>Red gravel</u>	<u>60</u>	<u>80</u>
<u>white Chalk</u>	<u>80</u>	<u>110</u>
<u>Coarse sand</u>	<u>110</u>	<u>122</u>

WELL LOCATION:
 sec. 26 T. 5 N R. 6 E
8 miles NW of Summit
 (distance) (direction) (nearest town)

WELL PURPOSE: Home
 (home, irrigation, municipal, industrial)

- WELL COMPLETION DATA:
- (1) diameter (inches) 4
 - (2) total depth (feet) 122
 - (3) static water level (feet) 85 below above top of ground.
 - (4) casing Plastic 116,
 (material) (depth)
4 if telescope see back.
 (size)
 - (5) screen 6', 116
 (length) (depth to top)
4, plastic
 (size) (material)
 - (6) pump 7 7
 (HP) (yield gpm)
blue
 (type power)
 - (7) electric log No
 (yes or no)
 (organization running log)
 - (8) how well bottom plugged wood peg


CODED

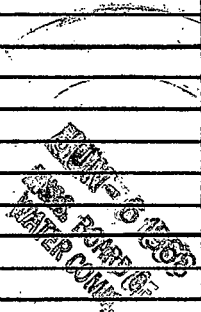

DRILLERS REMARKS:

If well telescopes please sketch and show depths.

GROUND LEVEL

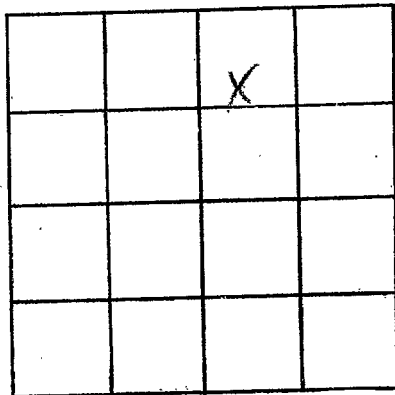

SECTION 26

Please indicate well location X.

ADDITIONAL INFORMATION

If more than one screen, show locations of each on sketch.