

CODED

Lincoln
012
8-68

MISSISSIPPI
BOARD OF WATER COMMISSIONERS
416 North State Street
Jackson, Mississippi 39201

WATER WELL DRILLERS LOG

Aug 30 1968 ST. T. Carington Lincoln
date well completed firm name county well located

LANDOWNER: W. V. Davis

description of formations encountered

from to

2149
Sand & Gravel

0 215
115 126

(mailing address)

WELL LOCATION:

sec 25 T 5 N R 6 E
S W

11 miles N.W. of Summit
(distance) (direction) (nearest town)

WELL PURPOSE: Home
(home, irrigation, municipal, industrial)

WELL COMPLETION DATA:

(1) diameter (inches) 4"
(2) total depth (feet) 126'
(3) static water level (feet) 90' below
top of ground.

(4) casing Plastic 120'
(material) (depth)

4" if telescope see back.
(size)

(5) screen 6' 126'
(length) (depth to top)

2" Plastic
(size) (material)

(6) pump ✓ 8
(HP) (yield gpm)


A.C.
(type power)

(7) electric log _____
(yes or no)

(organization running log)

(8) how well bottom plugged wood

DRILLERS REMARKS:

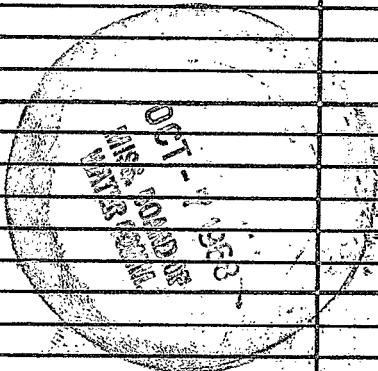

If well telescopes please sketch and show depths.

GROUND LEVEL

SECTION 26

Please indicate well location X.

ADDITIONAL INFORMATION

If more than one screen, show locations of each on sketch.