

Lincoln
 013
 10-19-68

MISSISSIPPI
 BOARD OF WATER COMMISSIONERS
 416 North State Street
 Jackson, Mississippi 39201

CODED

WATER WELL DRILLERS LOG

10-19 1968 *Fitzgerald Well Serv* *Lincoln*
 date well completed firm name county well located

LANDOWNER: *Luther Johnson*

description of formations encountered

from to

RR. Summit Min.

Red clay 0 15

Red sand 15 80

(mailing address)

Coarse sand & gravel 80 100

WELL LOCATION:

sec. *16* T. *5* N. R. *6* E.
9 miles *W* of *Summit*
 (distance) (direction) (nearest town)

WELL PURPOSE: *none*
 (home, irrigation, municipal, industrial)

WELL COMPLETION DATA:

(1) diameter (inches) *4*

(2) total depth (feet) *100*

(3) static water level (feet) *60* below above top of ground.

(4) casing *Plastic 94*,
 (material) (depth)

4 if telescope see back.
 (size)

(5) screen *6 94*,
 (length) (depth to top)

6 Plastic
 (size) (material)

(6) pump *3/4 7*
 (HP) (yield gpm)


Electric
 (type power)

(7) electric log *no*
 (yes or no)

(organization running log)


(8) how well bottom plugged *covered by*

DRILLERS REMARKS:

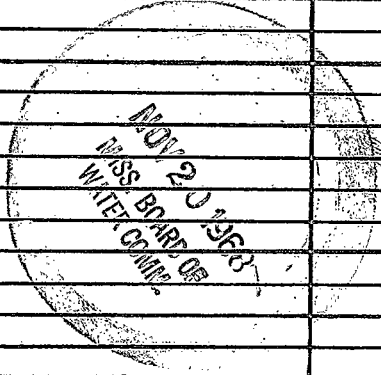

If well telescopes please sketch and show depths.

GROUND LEVEL

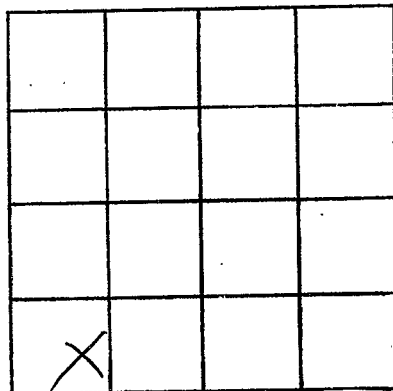

SECTION 16

Please indicate well location X.

ADDITIONAL INFORMATION

If more than one screen, show locations of each on sketch.