

Lincoln
 φ 16
 2-27-70

MISSISSIPPI
 BOARD OF WATER COMMISSIONERS
 416 North State Street
 Jackson, Mississippi 39201

CODED

WATER WELL DRILLERS LOG

2-27 1970 Fitzgerald Well Serv Lincoln
 date well completed firm name county well located

LANDOWNER:
Hathon Casley
RR. Smithdaley Miss.
 (mailing address)

| description of formations encountered | from | to |
|---------------------------------------|------|----|
| Real clay | 0 | 15 |
| Real sand | 15 | 60 |
| Course sand & gravel | 60 | 98 |

WELL LOCATION:
 sec. 29 T-5 R. 6
12 miles WNW of Scamp
 (distance) (direction) (nearest town)

WELL PURPOSE: home
 (home, irrigation, municipal, industrial)

WELL COMPLETION DATA:

(1) diameter (inches) 4

(2) total depth (feet) 98

(3) static water level (feet) 65 below above top of ground.

(4) casing Plastic 90
 (material) (depth)
4 if telescope see back.
 (size)

(5) screen 8 90
 (length) (depth to top)
4 (size) Plastic (material)

(6) pump 1/2 10
 (HP) (yield gpm)
Electric (type power)

(7) electric log no
 (yes or no)
 (organization running log)

(8) how well bottom plugged wood peg

CODED

MAR 16 1970


MAR 16 1970

MISS. Bd. OF
 WATER COMM.

DRILLERS REMARKS:

If well telescopes please sketch and show depths.

GROUND LEVEL

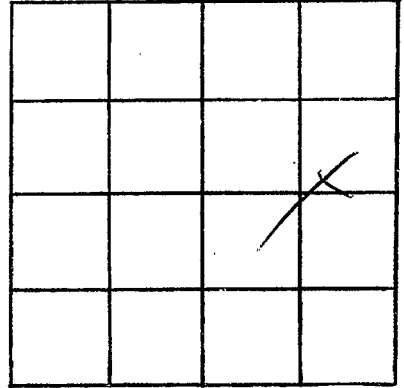

SECTION 29

Please indicate well location X.

ADDITIONAL INFORMATION

If more than one screen,
show locations of each on sketch.