

MISSISSIPPI  
BOARD OF WATER COMMISSIONERS  
416 North State Street  
Jackson, Mississippi 39201

**CODED**

WATER WELL DRILLERS LOG

LINCOLN  
Ø 18  
6-8-70

*Lincoln*  
~~Franklin~~

8 Jul  
date well completed


1970 *H.T. Construction*  
firm name

county well located

LANDOWNER:	description of formations encountered	from	to
<i>Bk. Covant</i>			
<i>M. L. L. Creek</i> (mailing address)	<i>Clay</i> <i>Clay Path</i> <i>Red Path</i>	<i>0</i> <i>12</i> <del><i>25</i></del>	<i>12</i> <i>25</i> <i>57</i>
WELL LOCATION: sec. <i>5</i> T. <i>5</i> N. R. <i>6</i> E <i>5</i> miles <i>N-W</i> of <i>Arkum</i> (distance) (direction) (nearest town)			
WELL PURPOSE: <i>Home</i> (home, irrigation, municipal, industrial)			
WELL COMPLETION DATA:	<b>CODED</b>		
(1) diameter (inches) <i>4</i>			
(2) total depth (feet) <i>57</i>			
(3) static water level (feet) <i>30</i> below above top of ground.			
(4) casing <i>pl.</i> <i>51</i> (material) (depth)			
(size) if telescope see back.			
(5) screen <i>6'</i> <i>51</i> (length) (depth to top)			
<i>4</i> <i>pl.</i> (size) (material)			
(6) pump <i>1/2</i> <i>8</i> (HP) (yield gpm)			
<i>slur</i> (type power)			
(7) electric log _____ (yes or no)			
(organization running log)			
(8) how well bottom plugged <i>used</i>			
DRILLERS REMARKS:	AUG 7 1970		
	MISS. BD. OF		
	WATER COMM.		

If well telescopes please sketch and show depths.

GROUND LEVEL

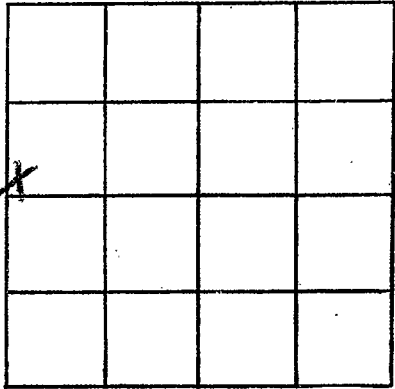

SECTION 5

Please indicate well location X.

ADDITIONAL INFORMATION

A series of 20 horizontal lines for entering additional information.

If more than one screen, show locations of each on sketch.