

LINCOLN  
 019  
 1-12-71

MISSISSIPPI  
 BOARD OF WATER COMMISSIONERS  
 416 North State Street  
 Jackson, Mississippi 39201

**CODED**

WATER WELL DRILLERS LOG

12 Jan 1971 *S.P. Water Well Lincoln*  
 date well completed firm name county well located

LANDOWNER:  
*Harold Albritton*  
*Beggs Chitto*  
 (mailing address)

description of formations encountered	from	to
<i>clay</i>	<i>0</i>	<i>15</i>
<i>good clay</i>	<i>15</i>	<i>38</i>
<i>chert</i>	<i>30</i>	<i>50</i>
<i>sand</i>	<i>50</i>	<i>96</i>

WELL LOCATION:  
 sec. *14* T. *5* N R. *6* E  
*10* miles *N* west of *Summit*  
 (distance) (direction) (nearest town)

WELL PURPOSE:  
 (home, irrigation, municipal, industrial)

WELL COMPLETION DATA:

(1) diameter (inches) *4"*

(2) total depth (feet) *96*

(3) static water level (feet) *65* below above top of ground.

(4) casing *pl* *90*  
 (material) (depth)  
 (size) if telescope see back.

(5) screen *6* *90*  
 (length) (depth to top)  
*4* *pl*  
 (size) (material)

(6) pump *1/2* *8*  
 (HP) (yield gpm)  
*ghost*  
 (type power)

(7) electric log (yes or no)

(organization running log)

(8) how well bottom plugged *wood*

**CODED**


FEB 26 1971

MISS. DEP. OF  
 WATER CONTROL

DRILLERS REMARKS:

If well telescopes please sketch and show depths.

GROUND LEVEL

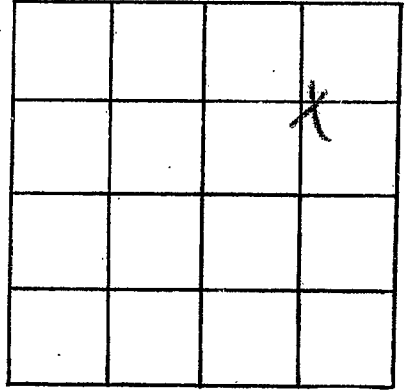

SECTION 14

Please indicate well location X.

ADDITIONAL INFORMATION

If more than one screen,  
show locations of each on sketch.