

MISSISSIPPI
BOARD OF WATER COMMISSIONERS
416 North State Street
Jackson, Mississippi 39201

CODED

WATER WELL DRILLERS LOG

LINCOLN
Φ 20
5-12-71

12 May 1971 date well completed
S & P Watson well firm name
Lincoln county well located

LANDOWNER:
Robert Noyes
Smithdale
(mailing address)

description of formations encountered	from	to
Clay	0	12
Chalky Sand	15	27
Chalk	30	45
Chalky Sand	45	60
Sand	60	70
Sand	70	87

WELL LOCATION:
sec. 33 T 5 N R 6 E
18 miles west of Summit
(distance) (direction) (nearest town)

WELL PURPOSE:
(home, irrigation, municipal, industrial)

WELL COMPLETION DATA:

(1) diameter (inches) 4"

(2) total depth (feet) 87

(3) static water level (feet) 65 below above top of ground.

(4) casing 4" 77 (material) (depth)

(size) If telescope see back.

(5) screen 6 77 (length) (depth to top)

4" 4" (size) (material)

(6) pump 1/2 8 (HP) (yield gpm)

elect (type power)

(7) electric log (yes or no)

CODED

(organization running log)

(8) how well bottom plugged wood


JAN 11 1971

MISS. BU. OF WATER COMMISSIONERS

DRILLERS REMARKS:

If well telescopes please sketch and show depths.

GROUND LEVEL

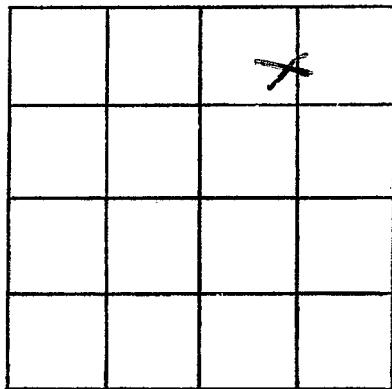

SECTION 33

Please indicate well location X.

ADDITIONAL INFORMATION

If more than one screen,
show locations of each on sketch.