

LINCOLN
021
8-11-71

MISSISSIPPI
 BOARD OF WATER COMMISSIONERS
 416 North State Street
 Jackson, Mississippi 39201

CODED

WATER WELL DRILLERS LOG

11 Aug 1971 date well completed SPL Water Well firm name Lincoln county well located

LANDOWNER: James Toak
Bozue Chitto
 (mailing address)

description of formations encountered	from	to
<u>Clay</u>	<u>0</u>	<u>20</u>
<u>Chalk</u>	<u>20</u>	<u>45</u>
<u>Good Chalk</u>	<u>45</u>	<u>65</u>
<u>Good</u>	<u>65</u>	<u>105</u>

WELL LOCATION:
 sec 23 T 5 N S R 6 E W
1.0 miles N of Sumner
 (distance) (direction) (nearest town)

WELL PURPOSE:
 (home, irrigation, municipal, industrial)

- WELL COMPLETION DATA:
- (1) diameter (inches) 4"
 - (2) total depth (feet) 105
 - (3) static water level (feet) 70 below above top of ground.
 - (4) casing PI 99,
 (material) (depth)
 (size) if telescope see back.
 - (5) screen 6 99
 (length) (depth to top)
1/2 PI
 (size) (material)
 - (6) pump 1/2 8
 (HP) (yield gpm)
Elect
 (type power)
 - (7) electric log (yes or no)

CODED

(organization running log)

(8) how well bottom plugged wood


OCT 18 1971

MISS. BLD. OF
 WATER COMMISSIONERS

DRILLERS REMARKS:

If well telescopes please sketch and show depths.

GROUND LEVEL

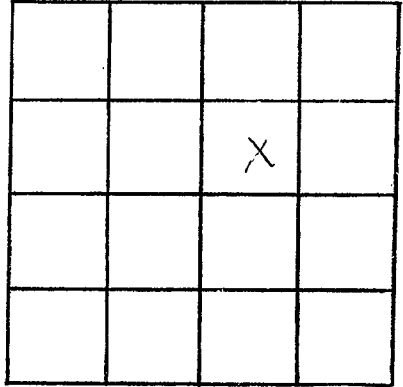

SECTION 23

Please indicate well location X.

ADDITIONAL INFORMATION

If more than one screen,
show locations of each on sketch.