

LINCOLN

022

9-22-71

MISSISSIPPI BOARD OF WATER COMMISSIONERS
416 North State Street
Jackson, Mississippi 39201

CODED

WATER WELL DRILLERS LOG

Lincoln
~~Amite~~

22 Sept 1971

S. V. P. Waterwell

county well located

LANDOWNER:

Clayton Johnson

Tim H. Dale

(mailing address)

WELL LOCATION:

sec. 32 T 5 N R 6 E
10 miles W of Sumner
(distance) (direction) (nearest town)

WELL PURPOSE:

(home, irrigation, municipal, industrial)

WELL COMPLETION DATA:

- (1) diameter (inches) 4
- (2) total depth (feet) 115
- (3) static water level (feet) 60 below above top of ground.
- (4) casing pl 109
(material) (depth)
 if telescope see back.
(size)
- (5) screen 6 109
(length) (depth to top)
1/2 pl
(size) (material)
- (6) pump 1/2 8
(HP) (yield gpm)
elect
(type power)
- (7) electric log
(yes or no)

(organization running log)

(8) how well bottom plugged Wood

description of formations encountered

from

to

<i>clay</i>	0	15
<i>clay</i>	15	25
<i>sand</i>	25	40
<i>sand</i>	40	65
<i>clay</i>	65	70
<i>sand</i>	70	115

CODED


NOV 10 1971

DRILLERS REMARKS:

MISS. BD. OF
WATER
COMMISSIONERS

If well telescopes please sketch and show depths.

GROUND LEVEL

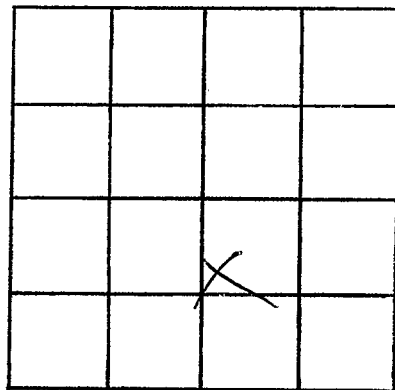

SECTION 22

Please indicate well location X.

ADDITIONAL INFORMATION

Lined area for additional information.

If more than one screen, show locations of each on sketch.