

LINCOLN
D 23
4-15-72

MISSISSIPPI
 BOARD OF WATER COMMISSIONERS
 416 North State Street
 Jackson, Mississippi 39201

CODED

WATER WELL DRILLERS LOG

15 April 1972 *SFA Water Well Service* firm name *Lincoln* county well located

LANDOWNER:
John Tabian
Reggie Chitto
 (mailing address)

description of formations encountered	from	to
clay	0	15
chalky sand	15	40
clay	40	70
clay	70	78
clay	78	95
sand	95	130

WELL LOCATION:
 sec. 35 T 5 N R 6 E
 6 miles west of *T.S.*
 (distance) (direction) (nearest town)

WELL PURPOSE:
 (home, irrigation, municipal, industrial)

- WELL COMPLETION DATA:
- (1) diameter (inches) 4
 - (2) total depth (feet) 130
 - (3) static water level (feet) 70 below top of ground.
 - (4) casing pl (material), 124 (depth)
 (size) if telescope see back.
 - (5) screen 6 (length), 124 (depth to top)
cc (size), pl (material)
 - (6) pump 1/2 (HP), 3 (yield gpm)
elect (type power)
 - (7) electric log (yes or no) _____

CODED

(organization running log)
 (8) how well bottom plugged Wood


APR 1 1972

MISS. BD. OF
 WATER COMMISSIONERS

DRILLERS REMARKS:

If well telescopes please sketch and show depths.

GROUND LEVEL

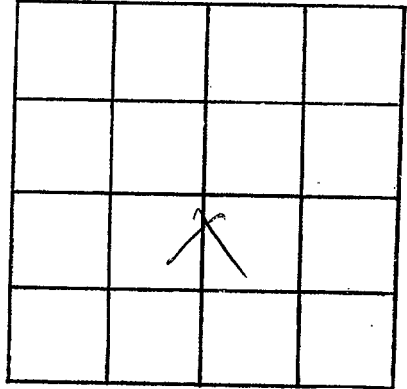

SECTION 35

Please indicate well location X.

ADDITIONAL INFORMATION

Lined area for additional information.

If more than one screen, show locations of each on sketch.