

LINCOLN
 024
 4-6-72

MISSISSIPPI
 BOARD OF WATER COMMISSIONERS
 416 North State Street
 Jackson, Mississippi 39201

CODED

WATER WELL DRILLERS LOG

April 6 1972 *chester keenes* *Lincoln*
 date well completed firm name county well located

LANDOWNER *Albert Edward*
RFD. Bagnschutte
 (mailing address)

description of formations encountered	from	to
<i>Red Sandy clay</i>	<i>0</i>	<i>17</i>
<i>Red sand</i>	<i>17</i>	<i>55</i>
<i>Brown sand gravel</i>	<i>55</i>	<i>70</i>
<i>gray white sand gravel</i>	<i>70</i>	<i>75</i>

WELL LOCATION:
 sec. 1 T. 5 N. R. 6 E
7 miles *W* *Bagnschutte*
 (distance) (direction) (nearest town)

WELL PURPOSE: *Home*
 (home, irrigation, municipal, industrial)

- WELL COMPLETION DATA:
- (1) diameter (inches) 4"
 - (2) total depth (feet) 75
 - (3) static water level (feet) 50 below top of ground.
 - (4) casing Plast Bottom
 (material) (depth)
 - (size) if telescope see back.
 - (5) screen 6' 69'
 (length) (depth to top)
4" Plast
 (size) (material)
 - (6) pump 1/2 HP 3
 (type power) (yield gpm)
 - (7) electric log No
 (yes or no)

CODED

(organization running log)

(8) how well bottom plugged *wooden plug*


DRILLERS REMARKS:
new house.

JUN 30 1972

MISS. B.D. 78
 MISSISSIPPI

If well telescopes please sketch and show depths.

GROUND LEVEL

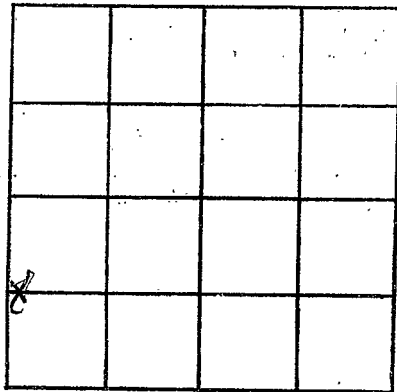

SECTION 1

Please indicate well location X.

ADDITIONAL INFORMATION

If more than one screen, show locations of each on sketch.