

LINCOLN
 Ø 26
 3-14-72

MISSISSIPPI
 BOARD OF WATER COMMISSIONERS
 416 North State Street
 Jackson, Mississippi 39201

CODED

WATER WELL DRILLERS LOG

March 14, 1972 date well completed
 Chester Keene firm name
 Lincoln county well located

LANDOWNER: John M. Kelly
 Rt 2, Summit
 (mailing address)

WELL LOCATION:
 section T 5 N R 6 E
 3 miles ENE of Auburn
 (distance) (direction) (nearest town)

WELL PURPOSE: Home
 (home, irrigation, municipal, industrial)

- WELL COMPLETION DATA:
- (1) diameter (inches) 4"
 - (2) total depth (feet) 115
 - (3) static water level (feet) 72 below top of ground
 - (4) casing Plastic Ballbon (material) (depth)
 - (size) If telescope see back.
 - (5) screen 6' (length) 109' (depth to top)
 4" (size) Plastic (material)
 - (6) pump 1/2 HP (HP) 100 (yield gpm)
 Elec (type power)
 - (7) electric log no (yes or no)
 - (organization running log)

description of formations encountered	from	to
yellow clay	0	22
Red Sandy clay	22	72
Small gravel	72	81
loblolly	81	102
Small gravel sand	102	115

CODED

DEC 30 1972


(8) how well bottom plugged
 wood plug

DRILLERS REMARKS:
 all well bed

MISSISSIPPI BOARD OF WATER COMMISSIONERS
 JACKSON, MISSISSIPPI 39201

If well telescopes please sketch and show depths.

GROUND LEVEL

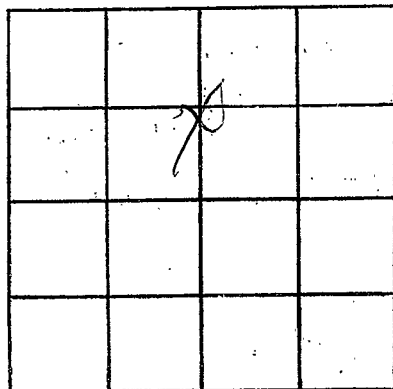

SECTION 25

Please indicate well location X.

ADDITIONAL INFORMATION

If more than one screen, show locations of each on sketch.