

Lincoln
Ø 27
5-11-72

MISSISSIPPI
 BOARD OF WATER COMMISSIONERS
 416 North State Street
 Jackson, Mississippi 39201

CODED

WATER WELL DRILLERS LOG

11 May 1972 SFP Water Well Lincoln
 date well completed firm name county well located

LANDOWNER:
 Donny Ahmed
 Sanit Adell Min.
 (mailing address)

description of formations encountered	from	to
Clay	0	25
Red Shale	25	30
Sand	50	60
Chalk Sand	60	70
Gravel	70	92

WELL LOCATION:
 sec. 15 T 9 N R 6 E
 S W 1/4
 4 miles N of Auburn
 (distance) (direction) (nearest town)

WELL PURPOSE:
 (home, irrigation, municipal, industrial)

- WELL COMPLETION DATA:
- (1) diameter (inches) 4
 - (2) total depth (feet) 92
 - (3) static water level (feet) 65 below above top of ground.
 - (4) casing Ø1 Ø6
 (material) (depth)
 - _____ if telescope see back.
 (size)
 - (5) screen 6 Ø6
 (length) (depth to top)
 - _____ _____
 (size) (material)
 - (6) pump 1/2 8
 (HP) (yield gpm)
 - _____ _____
 (type power)
 - (7) electric log _____
 (yes or no)
 - _____ (organization running log)
 - (8) how well bottom plugged Used

CODED


JUL 25 1972

DRILLERS REMARKS:

MISS. BD. OF
 WATER COMMISSIONERS

If well telescopes please sketch and show depths.

GROUND LEVEL

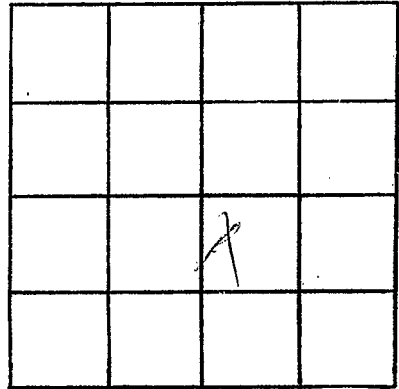

SECTION 15

Please indicate well location X.

ADDITIONAL INFORMATION

If more than one screen,
show locations of each on sketch.