

LINCOLN

MISSISSIPPI BOARD OF WATER COMMISSIONERS
416 North State Street
Jackson, Mississippi 39201

WATER WELL DRILLERS LOG

LINCOLN

~~Amite~~
029
8-4-72
4 Aug. 1972
date well completed

CODED

J. T. Cunningham & Son
firm name

~~Amite~~
county well located

LANDOWNER:

J. C. Pugh
Smith, Edal
(mailing address)

description of formations encountered

from to

Clay 0 20
Sand 20 45
Chalk 45 70
Red Sand 70 90
Sand 90 145

WELL LOCATION:

sec. 33 T. 5 N. R. 6 E
1/2 miles 5 of Auburn
(distance) (direction) (nearest town)

WELL PURPOSE:

(home, irrigation, municipal, industrial)

WELL COMPLETION DATA:

CODED

- (1) diameter (inches) 4
- (2) total depth (feet) 149
- (3) static water level (feet) 80 below top of ground
- (4) casing (material) 11 (depth) 143
- (5) screen (length) 6 (depth to top) 143
- (6) pump (size) 4 (material) 11 (HP) 3 (yield gpm)
- (7) electric log (yes or no)
- (8) how well bottom plugged Wood

if telescope see back.

(size) (material)

(HP) (yield gpm)

Elet. (type power)

(organization running log)


UGT 24 1972

DRILLERS REMARKS:

REC. NO. OF WATER COM.

If well telescopes please sketch and show depths.

GROUND LEVEL

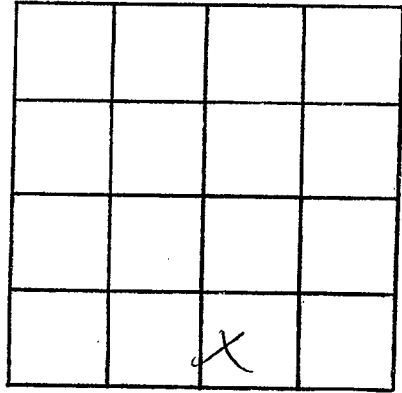

SECTION 33

Please indicate well location X.

ADDITIONAL INFORMATION

Lined area for additional information.

If more than one screen, show locations of each on sketch.