

LINCOLN

Ø 30

9-19-72

CODED

MISSISSIPPI BOARD OF WATER COMMISSIONERS
416 North State Street
Jackson, Mississippi 39201

WATER WELL DRILLERS LOG

10 Sept 1972

1972

J.T. Cooney & Son Lincoln

date well completed

firm name

county well located

LANDOWNER:

Essab Stokes
Bogus Church
(mailing address)

description of formations encountered

from

to

clay	0	20
red dirt	20	45
gravel	45	75
Chalk	75	90
red	90	118

WELL LOCATION:

sec. 26 T 5 N R 6 E
H miles W of C.C.

WELL PURPOSE:
(home, irrigation, municipal, industrial)

CODED

WELL COMPLETION DATA:

- (1) diameter (inches) 4
- (2) total depth (feet) 118
- (3) static water level (feet) 75 below top of ground.
- (4) casing 41 (material), 118 (depth)

if telescope see back.

- (5) screen 6 (length), 118 (depth to top)

4 (size), 41 (material)

- (6) pump 1/2 (HP), 8 (yield gpm)

elect (type power)

- (7) electric log (yes or no)

(organization running log)

- (8) how well bottom plugged wood


OCT 24 1972

DRILLERS REMARKS:

MISS. BD. OF WATER COM.

If well telescopes please sketch and show depths.

GROUND LEVEL

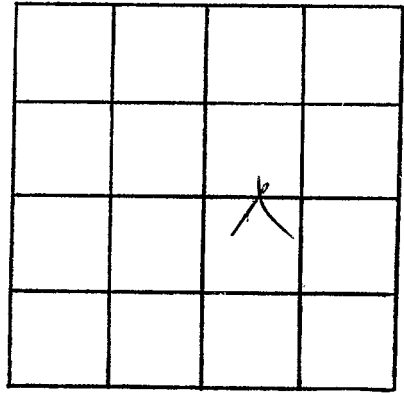

SECTION 76

Please indicate well location X.

ADDITIONAL INFORMATION

Lined area for additional information.

If more than one screen, show locations of each on sketch.