

LINCOLN  
 O 31  
 3-29-73

MISSISSIPPI  
 BOARD OF WATER COMMISSIONERS  
 416 North State Street  
 Jackson, Mississippi 39201

CODED

WATER WELL DRILLERS LOG

29 March 1973 J.T. Conroy & Son Lincoln  
 date well completed firm name county well located


LANDOWNER:	description of formations encountered	from	to
Jessie Cook P.O. Miss. (mailing address)	Clay red clay chka sand	0 15 30 40	15 30 40 91
<b>WELL LOCATION:</b> sec. 13 T 5 N R 6 E 8 miles N of Summit (distance) (direction) (nearest town)			
<b>WELL PURPOSE:</b> (home, irrigation, municipal, industrial)			
<b>WELL COMPLETION DATA:</b>			
(1) diameter (inches) 4			
(2) total depth (feet) 91			
(3) static water level (feet) 70 below top of ground.			
(4) casing (material) P1 (depth) 85			
_____ if telescope see back. (size)			
(5) screen (length) 6 (depth to top) 85			
_____ (size) _____ (material)			
(6) pump (HP) 6 (yield gpm) 8			
_____ (type power) elect			
(7) electric log _____ (yes or no)			
_____ (organization running log)			
(8) how well bottom plugged wood			
<b>DRILLERS REMARKS:</b>			

CODED

JUN 5 1973

If well telescopes please sketch and show depths.

GROUND LEVEL

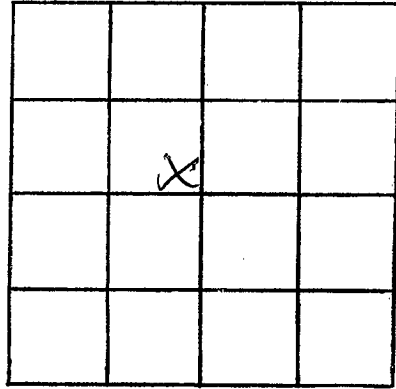

SECTION

13

Please indicate well location X.

ADDITIONAL INFORMATION

If more than one screen,  
show locations of each on sketch.