

Ø 33
 LINCOLN
 4-19-73

MISSISSIPPI
 BOARD OF WATER COMMISSIONERS
 416 North State Street
 Jackson, Mississippi 39201

CODED

WATER WELL DRILLERS LOG

April 19 1973 *Chute-Keeves* Lincoln
 date well completed firm name county well located

LANDOWNER: *Bunell
 Thompson
 RFD Bogachitto*
 (mailing address)

WELL LOCATION:
 sec. 3 T. 5 N. R. 6 E
6 1/2 miles *SW* *Bogachitto*
 (distance) (direction) (nearest town)

WELL PURPOSE: *Home*
 (home, irrigation, municipal, industrial)

- WELL COMPLETION DATA:
- (1) diameter (inches) 4"
 - (2) total depth (feet) 93
 - (3) static water level (feet) 62 below top of ground.
 - (4) casing Plast Ballou's
 (material) (depth)
 - _____ If telescope see back.
 (size)
 - (5) screen 6' 87'
 (length) (depth to top)
 - 4" Plast
 (size) (material)
 - (6) pump 1/2 Sub - 15
 (HP) (yield gpm)
 - Elect
 (type power)
 - (7) electric log No.
 (yes or no)
 - _____ (organization running log)
 - (8) how well bottom plugged wooden plug

description of formations encountered	from	to
<i>Red clay</i>	<i>0</i>	<i>17</i>
<i>Red Sand</i>	<i>17</i>	<i>58</i>
<i>Sand, gravel, chert</i>	<i>58</i>	<i>72</i>
<i>cherty sand</i>	<i>72</i>	<i>85</i>
<i>Requaint loose sand</i>	<i>85</i>	<i>93</i>


CODED

DRILLERS REMARKS:
old well had

AUG 20 1973

If well telescopes please sketch and show depths.

GROUND LEVEL

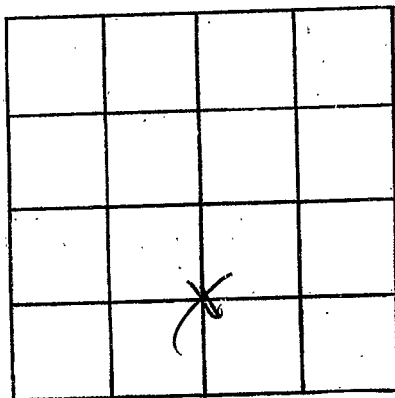

SECTION 3

Please indicate well location X.

ADDITIONAL INFORMATION

If more than one screen, show locations of each on sketch.