

**LINCOLN**  
**Φ 35**  
**2-22-74**

MISSISSIPPI  
 BOARD OF WATER COMMISSIONERS  
 416 North State Street  
 Jackson, Mississippi 39201

**CODED**

**WATER WELL DRILLERS LOG**

22 Feb 1974 J.T. Compton & Son Inc. Lincoln  
 date well completed firm name county well located

LANDOWNER:  
 B.A. Taylor  
 (mailing address)

WELL LOCATION:  
 sec. 33 T 5 N R 6 E  
 2 miles N of Jackson  
 (distance) (direction) (nearest town)

description of formations encountered	from	to
Clay	0	10
Reddish	20	25
Sand	45	74

WELL PURPOSE:  
 (home, irrigation, municipal, industrial)

WELL COMPLETION DATA:

(1) diameter (inches) 4

(2) total depth (feet) 74

(3) static water level (feet) 60 below top of ground.

(4) casing PI 68 (material) (depth)

(size) If telescope see back.

(5) screen 6 68 (length) (depth to top)

4 PI (size) (material)

(6) pump 1/2 6 (HP) (yield gpm)

Electric (type power)

(7) electric log (yes or no)

(organization running log)

(8) how well bottom plugged *not*


**CODED**

DRILLERS REMARKS:

APR 17 1974

If well telescopes please sketch and show depths.

GROUND LEVEL

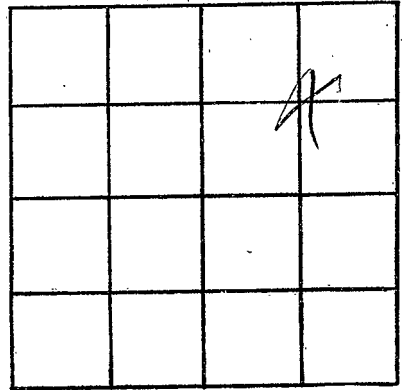

SECTION 33

Please indicate well location X.

ADDITIONAL INFORMATION

If more than one screen, show locations of each on sketch.