

LINCOLN
 # 36
 10-25-73

MISSISSIPPI
 BOARD OF WATER COMMISSIONERS
 416 North State Street
 Jackson, Mississippi 39201

CODED

WATER WELL DRILLERS LOG

Oct 25 1973 date well completed
 chester keener firm name
 Lincoln county well located

LANDOWNER: Larry
 Anderson
 RFD - Bogrechitto
 (mailing address)

description of formations encountered	from	to
Red clay	0	27
Red Chalk and Red Sand	27	103
Sand & gravel	103	111

WELL LOCATION:
 sec 13 T 5 N R 6 E
 5 miles W. SW of Noyfield
 (distance) (direction) (nearest town)

WELL PURPOSE: Home
 (home, irrigation, municipal, industrial)

WELL COMPLETION DATA:

- (1) diameter (inches) 4"
- (2) total depth (feet) 111
- (3) static water level (feet) 72 below top of ground
- (4) casing Plast Bottom
 (material) (depth)
 _____ if telescope see back.
 (size)
- (5) screen 6' 105'
 (length) (depth to top)
1 1/2" Plast
 (size) (material)
- (6) pump 4 hp 8
 (HP) (yield gpm)
skt
 (type power)
- (7) electric log no
 (yes or no)
- _____ (organization running log)
- (8) how well bottom plugged wood plug

CODED


RECEIVED
 MAY 21 1974

DRILLERS REMARKS:
 new house

MISS. BD. OF WATER COMMISSIONERS

If well telescopes please sketch and show depths.

GROUND LEVEL

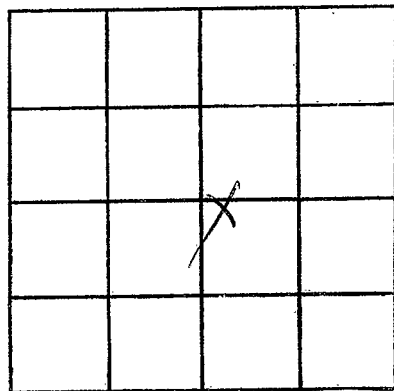

SECTION 13

Please indicate well location X.

ADDITIONAL INFORMATION

If more than one screen, show locations of each on sketch.

U.S. DEPT. OF WATER CONTROL