

LINCOLN
 037
 9/11/74

MISSISSIPPI
 BOARD OF WATER COMMISSIONERS
 416 North State Street
 Jackson, Mississippi 39201

CODED

WATER WELL DRILLERS LOG

11 sept 1974 J.T. Conington & Son Lincoln
 date well completed firm name county well located

LANDOWNER:
 Ada Addison
 Bogue Chitto
 (mailing address)

description of formations encountered	from	to
Cherty	0	20
Cherty	20	35
Silt	35	60
Good Rock	60	914

WELL LOCATION:
 sec. 1 T. 5 N. R. 6 E.
 4 miles W of B.C.
 (distance) (direction) (nearest town)

WELL PURPOSE:
 (home, irrigation, municipal, industrial)

CODED

WELL COMPLETION DATA:

- (1) diameter (inches) 4
- (2) total depth (feet) 94
- (3) static water level (feet) 70 below top of ground.
- (4) casing PL, 88 (material), (depth)
 (size) if telescope see back.
- (5) screen 6, 88 (length), (depth to top)
 (size), (material)
- (6) pump 2, No Pump (HP), (yield gpm)
 (type power)
- (7) electric log (yes or no)
 (organization running log)
- (8) how well bottom plugged wood


DRILLERS REMARKS:

RECEIVED
 DEC - 3 1974

MISS. BD. OF WATER COMMISSIONERS

If well telescopes please sketch and show depths.

GROUND LEVEL

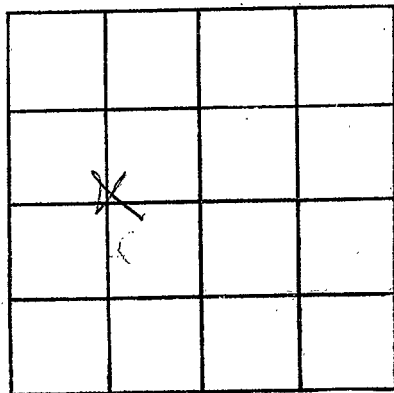

SECTION 1

Please indicate well location X.

ADDITIONAL INFORMATION

If more than one screen,
show locations of each on sketch.