

LINCOLN
 038
 9/27/74

MISSISSIPPI
 BOARD OF WATER COMMISSIONERS
 416 North State Street
 Jackson, Mississippi 39201

CODED

WATER WELL DRILLERS LOG

27 Sept 1974
 date well completed

J.T. Conrath
 firm name

Lincoln
 county well located

LANDOWNER:

Jimmy Porter

(mailing address)

WELL LOCATION:

sec. 1 T. 5 N R. 6 E
 6 miles W of B.C.
 (distance) (direction) (nearest town)

WELL PURPOSE:

(home, irrigation, municipal, industrial)

WELL COMPLETION DATA:

- (1) diameter (inches) 4
- (2) total depth (feet) 96
- (3) static water level (feet) 75 below top of ground.
- (4) casing 11 (material), 90 (depth), (size) if telescope see back.
- (5) screen 6 (length), 90 (depth to top), 11 (size), 11 (material)
- (6) pump 1/2 (HP), 8 (yield gpm), 3/4 (type power)
- (7) electric log (yes or no)

(organization running log)

- (8) how well bottom plugged wood

description of formations encountered

from to

clay	0	70
clay shale	70	48
2nd	40	70
2nd Rock	70	96

CODED


DRILLERS REMARKS:

RECEIVED

DEC 3 1974

If well telescopes please sketch and show depths.

GROUND LEVEL

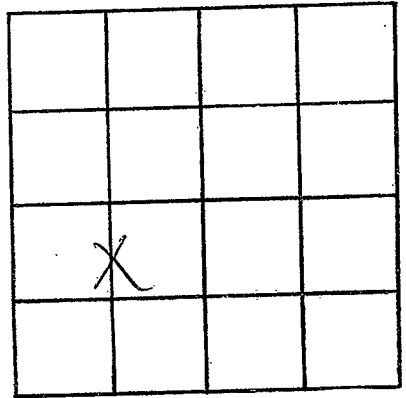

SECTION 1

Please indicate well location X.

ADDITIONAL INFORMATION

If more than one screen,
show locations of each on sketch.