

LINCOLN
Ø 40
7-15-75

MISSISSIPPI
 BOARD OF WATER COMMISSIONERS
 416 North State Street
 Jackson, Mississippi 39201

CODED

WATER WELL DRILLERS LOG

15 July
 date well completed

1975 J.T. Carrington
 firm name

Lincoln
 county well located

LANDOWNER:

Wayne Hodges
Reginald Chitto
 (mailing address)

description of formations encountered

from

to

clay 0 25
shale 25 60
sand 60 94

WELL LOCATION:

sec. 23 T 5 N R. 6 E
5 miles W of B.C.
 (distance) (direction) (nearest town)

WELL PURPOSE:

(home, irrigation, municipal, industrial)

WELL COMPLETION DATA:

- (1) diameter (inches) 4
- (2) total depth (feet) 94
- (3) static water level (feet) 75 below above top of ground.
- (4) casing PI, 88
 (material) (depth)
 (size) If telescope see back.
- (5) screen 6, 88
 (length) (depth to top)
4, PI
 (size) (material)
- (6) pump 1/2, 5
 (HP) (yield gpm)
elit
 (type power)
- (7) electric log _____
 (yes or no)

 (organization running log)
- (8) how well bottom plugged wood

DRILLERS REMARKS:


AUG 21 1975

MISS. RD. OF WATER COMMISSIONERS

20/11/11

If well telescopes please sketch and show depths.

GROUND LEVEL

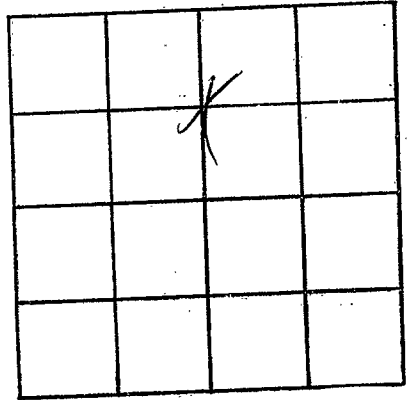

SECTION 23

Please indicate well location X.

ADDITIONAL INFORMATION

If more than one screen,
show locations of each on sketch.