

CODED

MISSISSIPPI
BOARD OF WATER COMMISSIONERS
416 North State Street
Jackson, Mississippi 39201

Lincoln
2041
8-11-75

WATER WELL DRILLERS LOG

11 Aug 1975 date well completed F. T. Covington & Son, Inc. firm name Lincoln county well located

LANDOWNER:
Thomas Alfred
Smithdale
(mailing address)

description of formations encountered	from	to
<u>Clay</u>	<u>0</u>	<u>25</u>
<u>Chalk</u>	<u>25</u>	<u>65</u>
<u>Sand</u>	<u>65</u>	<u>84</u>

WELL LOCATION:
sec 27 T 5 N 3 S R 6 E 146
2 miles NE of Polk
(distance) (direction) (nearest town)

WELL PURPOSE:
(home, irrigation, municipal, industrial)

- WELL COMPLETION DATA:
- (1) diameter (inches) 4
 - (2) total depth (feet) 94
 - (3) static water level (feet) 70 below top of ground.
 - (4) casing PI 88
(material) (depth)
 if telescope see back.
(size)
 - (5) screen 6 88
(length) (depth to top)
4 PI
(size) (material)
 - (6) pump 1/2 8
(HP) (yield gpm)
Elect
(type power)
 - (7) electric log
(yes or no)


(organization running log)
 - (8) how well bottom plugged wood

DRILLERS REMARKS:

OCT 6 1975

If well telescopes please sketch and show depths.

GROUND LEVEL

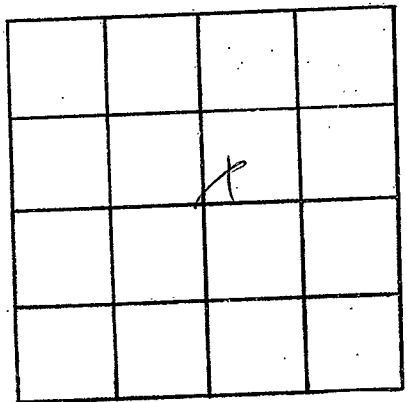

SECTION 27

Please indicate well location X.

ADDITIONAL INFORMATION

If more than one screen, show locations of each on sketch.