

CODED

Lincoln
D 42
7-5-75

MISSISSIPPI
BOARD OF WATER COMMISSIONERS
416 North State Street
Jackson, Mississippi 39201

WATER WELL DRILLERS LOG

July 5 1975 Remond Milling Co Lincoln
date well completed firm name county well located


LANDOWNER:	description of formations encountered	from	to
<u>Nathaniel Crossley</u> <u>Rt 2 box 24 Northdale</u> (mailing address)	<u>Red clay</u> <u>sand & gravel</u> <u>pink chalk</u> <u>sand & gravel</u>	<u>0</u> <u>10</u> <u>30</u> <u>47</u>	<u>10</u> <u>30</u> <u>47</u> <u>95</u>
WELL LOCATION: sec <u>20</u> T <u>5</u> N R <u>6</u> E <u>14G</u> <u>2 1/2</u> miles <u>north</u> of <u>Cubana</u> (distance) (direction) (nearest town)			
WELL PURPOSE: <u>home</u> (home, irrigation, municipal, industrial)			
WELL COMPLETION DATA:			
(1) diameter (inches) <u>4"</u>			
(2) total depth (feet) <u>95</u>			
(3) static water level (feet) <u>45</u> below top of ground.			
(4) casing <u>plastic</u> (material) <u>bottom</u> (depth)			
_____ if telescope see back. (size)			
(5) screen <u>6'</u> (length) <u>89</u> (depth to top)			
_____ (size) <u>plastic</u> (material)			
(6) pump <u>3/4</u> (HP) <u>12</u> (yield gpm)			
_____ (type power) <u>elect</u>			
(7) electric log <u>no</u> (yes or no)			
_____ (organization running log)			
(8) how well bottom plugged <u>water plug</u>			
DRILLERS REMARKS: <u>new house site</u>			

DRILLER'S SIGNATURE
JUL 6 1975

MISS. Bd. OF WATER COMMISSIONERS

If well telescopes please sketch and show depths.

GROUND LEVEL

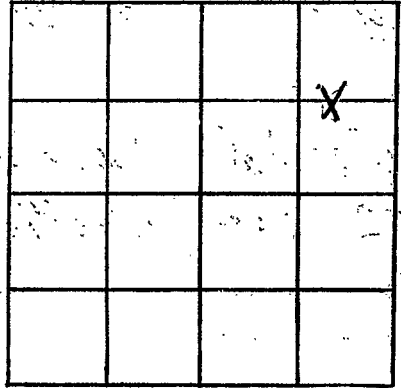

SECTION 20

Please indicate well location X.

ADDITIONAL INFORMATION

If more than one screen, show locations of each on sketch.

Handwritten notes at the bottom of the page.