

MISSISSIPPI DEPARTMENT OF NATURAL RESOURCES

Bureau of Land and Water Resources

Southport Mall

P.O. Box 10631

Jackson, Mississippi 39209

WATER WELL DRILLERS LOG

Griner Drilling Service, Inc.

Lincoln

LINCOLN
244
12/23/82

12-23-82
date well completed

firm name

county well located

LANDOWNER:
Oil Energy
P.O. Box 2088
Jackson, MS. 39201
(mailing address)

WELL LOCATION: *2356~~th~~ & 860~~th~~ St*
NO 1 sec 36 T 5 N R 60 of SW
McNulty
Est 1/2 mile miles *Olive Field*
(distance) (direction) (nearest town)

| description of formations encountered | from | to |
|---------------------------------------|------------|------------|
| <i>SAND - pea gravel</i> | <i>0</i> | <i>189</i> |
| <i>streaked</i> | <i>189</i> | <i>300</i> |

WELL PURPOSE: *Oil Field*
(home, irrigation, municipal, industrial)

WELL COMPLETION DATA:

(1) diameter (inches) *3"*

(2) total depth (feet) *300'*

(3) static water level (feet) *40'* *(below)* above top of ground.

(4) casing *Steel* *189'*
(material) (depth)
3"
(size) if telescope see back.

(5) screen *42'* *147'*
(length) (depth to top)
3" *perforated*
(size) (material)

(6) pump *—* *60*
(HP) (yield gpm)
AC
(type power)

(7) electric log *—*
(yes or no)
—
(organization running log)

(8) how well bottom plugged *Orange*
Deel

| |
|--------------|
| CODED |
|--------------|

DRILLERS REMARKS:


DEPT. OF NATURAL RESOURCES
BUREAU OF LAND & WATER RESOURCES

JAN 24 1983

RECEIVED

If well telescopes please sketch and show depths.

GROUND LEVEL

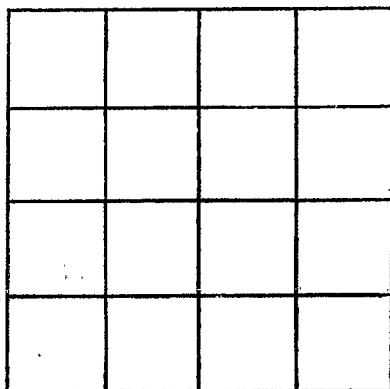

SECTION _____

Please indicate well location X.

ADDITIONAL INFORMATION

If more than one screen, show locations of each on sketch.