

MISSISSIPPI DEPARTMENT OF NATURAL RESOURCES

Bureau of Land and Water Resources

Southport Mall

P.O. Box 10631

Jackson, Mississippi 39209

WATER WELL DRILLERS LOG

CODED

LINCOLN
Q 46

March 9

1984

Reynolds & Son

Lincoln

date well completed

firm name

county well located

LANDOWNER:	description of formations encountered	from	to
Joe Maach Rt Brodhaner (mailing address)			
WELL LOCATION:	CODED		
sec. <u>5</u> T. <u>5</u> N. R. <u>6</u> E <u>5 1/2</u> miles <u>north</u> of <u>Auburn</u> (distance) (direction) (nearest town)			
WELL PURPOSE: <u>Truck</u> (home, irrigation, municipal, industrial)			
WELL COMPLETION DATA:			
(1) diameter (inches) <u>4"</u>			
(2) total depth (feet) <u>101</u>			
(3) static water level (feet) <u>70</u> below top of ground.			
(4) casing <u>plastic</u> , <u>bottom</u> (material) (depth)			
(size) If telescope see back.			
(5) screen <u>6'</u> , <u>95'</u> (length) (depth to top)			
(size) <u>4"</u> , <u>plastic</u> (material)			
(6) pump <u>1/2</u> HP, <u>10</u> (type power) (yield gpm)			
(7) electric log <u>no</u> (yes or no)			
(organization running log)			
(8) how well bottom plugged <u>back wash</u>			
DRILLERS REMARKS:			


DEPT. OF NATURAL RESOURCES
BUREAU OF LAND & WATER RESOURCES

JUL 2 1984

RECEIVED

If well telescopes please sketch and show depths.

GROUND LEVEL

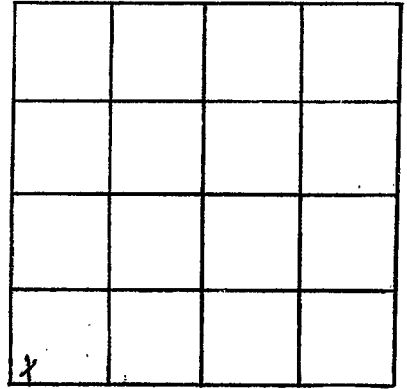

SECTION 5

Please indicate well location X.

ADDITIONAL INFORMATION

If more than one screen,
show locations of each on sketch.