

MISSISSIPPI DEPARTMENT OF NATURAL RESOURCES

Bureau of Land and Water Resources

Southport Mall

P.O. Box 10631

Jackson, Mississippi 39209

CODED

WATER WELL DRILLERS LOG

Lincoln
 48
 7/30/84

7-30-84 date well completed
 Griner Drilling Service, Inc. firm name
 Lincoln county well located

LANDOWNER:
 Cities Service Oil & Gas Corp.
 P.O. Box 12026
 Jackson, Ms. 39211
 (mailing address)

description of formations encountered	from	to
clay, sand	0	21
sand	21	42
gravel, chalk, rock	42	84
sand, pea gravel	84	147
CHALK	147	168

WELL LOCATION: 660' N + 660' E
 No. 1 sec. 35 T 5 N R 6 E of Diamond JA Auburn of SW/4 cor
 (distance) (direction) (nearest town)

WELL PURPOSE:
 (home, irrigation, municipal, industrial)

WELL COMPLETION DATA:

(1) diameter (inches) 3"

(2) total depth (feet) 168'

(3) static water level (feet) 40' below top of ground.

(4) casing steel 147' (material) (depth)
 3" (size) if telescope see back.

(5) screen 42' 105' (length) (depth to top)
 3" perforated (size) (material)

(6) pump N/A 70 (HP) (yield gpm)
 AC (type power)

(7) electric log (yes or no)

(organization running log)

(8) how well bottom plugged orange peel

DRILLERS REMARKS:

CODED


DEPT. OF NATURAL RESOURCES
 BUREAU OF LAND & WATER RESOURCES

AUG 6 1984

RECEIVED

If well telescopes please sketch and show depths.

GROUND LEVEL

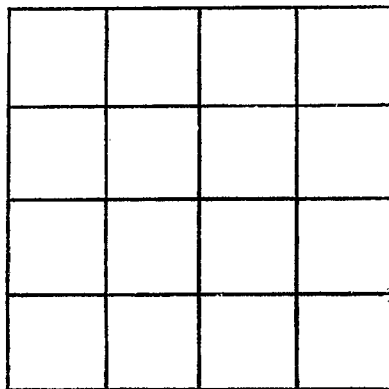

SECTION _____

Please indicate well location X.

ADDITIONAL INFORMATION

If more than one screen, show locations of each on sketch.