

050
 Lincoln
 8-4-85

MISSISSIPPI
 BOARD OF WATER COMMISSIONERS
 416 North State Street
 Jackson, Mississippi 39201

CODED

WATER WELL DRILLERS LOG

Griner Drilling Service, Inc.

Lincoln

8-4-85
date well completed

firm name

county well located

LANDOWNER:

ENSERCH Exploration
 1230 River Bend Drive
 Suite 136
 Dallas, Texas 75247
 (mailing address)

description of formations encountered

from

to

sand, gravel

0 105

clay

105 231

sand, black pea gravel

231 290

sand stone, clay

290 294

WELL LOCATION: 1700 S 4 2306' W

sec. 16 T. 5 N R. 6 E of

NO. 1 Bd. of Ed. West Lincoln
(distance) miles (direction) (nearest town)

WELL PURPOSE: oilfield supply
(home, irrigation, municipal, industrial)

CODED

WELL COMPLETION DATA:

- (1) diameter (inches) 4"
- (2) total depth (feet) 294'
- (3) static water level (feet) 70' below top of ground.
- (4) casing steel 294' (material) (depth)
4" (size) if telescope see back.
- (5) screen 42' 252' (length) (depth to top)
4" perforated (size) (material)
- (6) pump — 75 (HP) (yield gpm)
AC (type power)
- (7) electric log (yes or no)

(organization running log)


- (8) how well bottom plugged orange peel

DRILLERS REMARKS:

RECEIVED
 SEP 23 1985
 Department of Natural Resources
 Bureau of Land & Water

If well telescopes please
sketch and show depths.

GROUND LEVEL

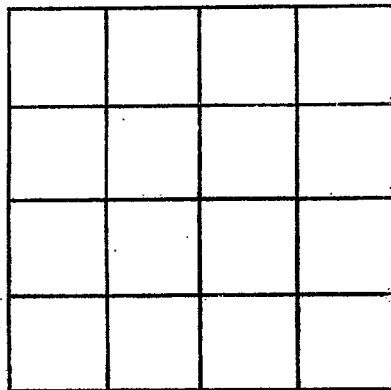

SECTION _____

Please indicate well location X.

ADDITIONAL INFORMATION

If more than one screen,
show locations of each on sketch.