

MISSISSIPPI DEPARTMENT OF NATURAL RESOURCES

Bureau of Land and Water Resources

Southport Mall

P.O. Box 10631

Jackson, Mississippi 39209

WATER WELL DRILLERS LOG

Griner Drilling Service, Inc.

Lincoln

<i>Lincoln</i>
<i>Φ 51</i>
<i>307 D</i>

Wooded

date well completed

firm name

county well located

10-13-87

LANDOWNER:
Henley Drilling
1401 Elm Street
Suite 3600
Dallas, TX 75202

description of formations encountered	from	to
<i>clay</i>	<i>0</i>	<i>60</i>
<i>sand, gravel</i>	<i>60</i>	<i>80</i>
<i>clay</i>	<i>80</i>	<i>90</i>
<i>sand, gravel</i>	<i>90</i>	<i>150</i>
<i>sand, gravel</i>	<i>150</i>	<i>190</i>
<i>clay</i>	<i>190</i>	<i>200</i>

WELL LOCATION: *990' S & 2139' W*
 sec. *35* T. *5* N. R. *6E* of
Hunt Co. 8 miles W of Vene/Co
 (distance) *Summit* (nearest town)

WELL PURPOSE: *oilfield rig*
 (home, irrigation, municipal, industrial)

WELL COMPLETION DATA:

- (1) diameter (inches) *3"*
- (2) total depth (feet) *200'*
- (3) static water level (feet) *60'* Below above top of ground.
- (4) casing (material) *steel*, (depth) *189'*
3" (size) if telescope see back.
- (5) screen (length) *42'*, (depth to top) *147'*
3" (size), *perforated* (material)
- (6) pump (HP) *65-70*, (yield gpm) *AC*
 (type power)
- (7) electric log (yes or no)

(organization running log)

(8) how well bottom plugged *orange peel*

DRILLERS REMARKS:


RECEIVED

OCT 28 1987

Department of Natural Resources
 Bureau of Land & Water Resources

If well telescopes please sketch and show depths.

GROUND LEVEL

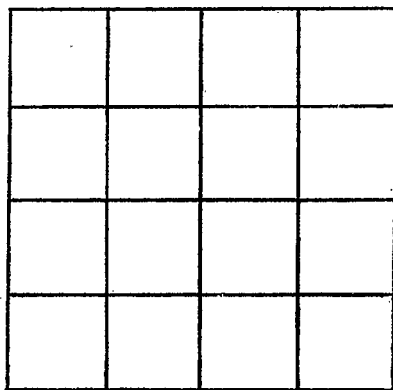

SECTION _____

Please indicate well location X.

ADDITIONAL INFORMATION

If more than one screen, show locations of each on sketch.