

MISSISSIPPI DEPARTMENT OF ENVIRONMENTAL QUALITY

Office of Land and Water Resources

P. O. Box 10631
Jackson, MS 39289-0631

WATER WELL DRILLERS LOG

COUNTY WELL LOCATED
Lincoln

WELL NUMBER
W-57

CODED

DATE WELL COMPLETED
4-5-03

PERMIT NUMBER

NAME OF DRILLING FIRM
R-Steel Well Serv

NAME & MAILING ADDRESS OF LANDOWNER
Jaslm Nowell

Montgomery Rd, Bogochite, MS

Latitude:
Longitude:

WELL LOCATION: SEC 19 TOWNSHIP S 3 RANGE 6

DISTANCE 5 MILES DIRECTION West NEAREST TOWN Bogochite

OTHER LANDMARK

WELL PURPOSE: Home Irrigation, Municipal, Industrial, Fish Pond, etc.

PUMP DATA

PUMP TYPE (Circle One):
 Submersible, Turbine, Jet, Flowing Well,
Other (Describe)

POWER TYPE (Circle One):
 Electric, Tractor, Diesel, Gasoline, Butane,
Other (Describe) H/P

DESCRIPTION OF FORMATIONS ENCOUNTERED	FROM	TO
<u>Clay</u>	<u>0</u>	<u>20</u>
<u>gravel</u>	<u>20</u>	<u>60</u>
<u>sand</u>	<u>60</u>	<u>80</u>
<u>clay</u>	<u>80</u>	<u>100</u>
<u>sand</u>	<u>100</u>	<u>120</u>
<u>course sand</u>	<u>120</u>	<u>130</u>

RECEIVED
MAY 07 2003
BY: OLWH

Top of Lap Pipe or Reduction in Casing

FEET IF TELESKOPED OR MORE THAN ONE SCREEN: USE BACK PAGE

WELL DATA

Well Depth 130' Casing Diameter (In.) 4" Casing Length (Ft.) 120'

Type of Casing PVC Hole Depth 130' Depth to Static Water Level 61'

TYPE OF COMPLETION: (Circle One or More):
 Gravel Packed, Underreamed, Telescoped,
Natural Development, Open Hole, Other
(Describe)

WELL GROUTED TO A DEPTH OF 10 FEET
Type Grout (circle one): Cement, Bentonite, or Mix

SCREEN DATA

Diameter - Inches 4" Length - Feet 10' Slot Size - Inches .012

Screen Type PVC Depth to Bottom - Feet 130'

I certify that the well was drilled, constructed and completed in accordance with all applicable Requirements of the Mississippi Department of Environmental Quality and/or the Mississippi Department of Health regulations and state laws.


Brad Stogard 029
Signature of Licensed Driller and License No.

5-5-03
Date

Additional Information Required On Back

If well telescopes please sketch and show depths.

GROUND LEVEL

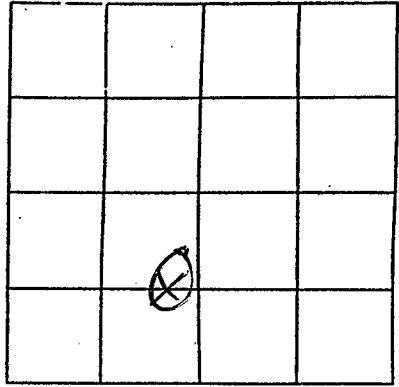

SECTION 19

Please indicate well location X.

Pump Capacity (GPM)	No. of Stages	Setting Depth	
<u>12</u>	<u>12</u>	<u>90</u>	FT.

PUMP TEST

Well yielded _____ GPM with a drawdown of _____ ft. after _____ hours of pumping

LOG DATA

TYPE OF LOG RUN (Circle One): No Log Run, Electric, Gamma Ray, Density, Sonic, Neutron, Other (Describe) _____

Name of Organization Running Log _____

GEOLOGIC DATA (Office Use Only)

Surface Elev.	Geologic Unit	Unit Thickness	Depth to Top
Subs. SWL	Date	Analysis	Aquifer Test

Driller's Remarks

If more than one screen, show location of each on sketch.