

MISSISSIPPI DEPARTMENT OF ENVIRONMENTAL QUALITY

Office of Land and Water Resources

P. O. Box 10631
Jackson, MS 39289-0631
WATER WELL DRILLERS LOG

COUNTY WELL LOCATED
Lincoln

WELL NUMBER 0-63 CODED

DATE WELL COMPLETED
6/1/04

PERMIT NUMBER

NAME OF DRILLING FIRM
Green Water Well & Supply, Inc.

NAME & MAILING ADDRESS OF LANDOWNER
Carroll Smith

2458 Hilton Ln SW, Smithdale

Latitude:
Longitude:

WELL LOCATION. SEC 8 TOWNSHIP 5^N RANGE 6^E

DISTANCE 10 Miles DIRECTION SW NEAREST TOWN Boguechitto

OTHER LANDMARK

WELL PURPOSE Home Irrigation, Municipal, Industrial, Fish Pond, etc.

PUMP DATA

PUMP TYPE (Circle One):
 Submersible Turbine, Jet, Flowing Well,
Other (Describe)

POWER TYPE (Circle One):
 Electric Tractor, Diesel, Gasoline, Butane,
Other (Describe) H/P 5

DESCRIPTION OF FORMATIONS ENCOUNTERED	FROM	TO
<u>red clay</u>	<u>0</u>	<u>20</u>
<u>sand streaks</u>	<u>20</u>	<u>52</u>
<u>sand & gravel</u>	<u>52</u>	<u>70</u>
<u>sand & gravel</u>	<u>70</u>	<u>121</u>
<u>yellow clay</u>	<u>121</u>	<u>124</u>

RECEIVED
JUN 15 2004
BY: OLWR

Top of Lap Pipe or Reduction in Casing
FEET IF TELESCOPED OR MORE THAN ONE SCREEN: USE BACK PAGE

WELL DATA

Well Depth <u>120</u>	Casing Diameter (In.) <u>4</u>	Casing Length (Ft.) <u>110</u>
Type of Casing <u>PVC</u>	Hole Depth <u>124</u>	Depth to Static Water Level <u>52</u>

TYPE OF COMPLETION: (Circle One or More):
 Gravel Packed, Underreamed, Telescoped,
Natural Development, Open Hole, Other (Describe)

WELL GROUTED TO A DEPTH OF 10 FEET
Type Grout (circle one): Cement, Bentonite, or Mix

SCREEN DATA

Diameter - Inches <u>4</u>	Length - Feet <u>10</u>	Slot Size - Inches <u>10/10</u>
Screen Type <u>PVC</u>	Depth to Bottom - Feet <u>120</u>	

I certify that the well was drilled, constructed and completed in accordance with all applicable Requirements of the Mississippi Department of Environmental Quality and/or the Mississippi Department of Health regulations and state laws.


Brian McClouden 664
Signature of Licensed Driller and License No.

6/1/04
Date

Additional Information Required On Back

If well telescopes please sketch and show depths.

GROUND LEVEL

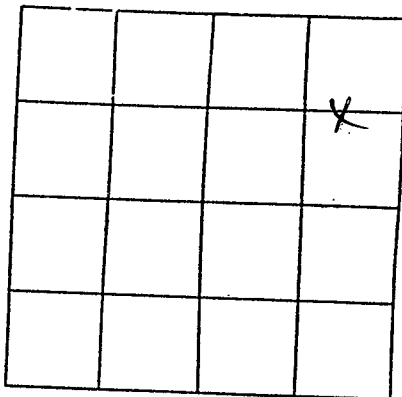

SECTION 8

Please indicate well location X.

Pump Capacity (GPM)	No. of Stages	Setting Depth
<u>10</u>	<u>9</u>	<u>75</u> FT.
PUMP TEST		
Well yielded <u>11</u> GPM with a drawdown of <u>1</u> ft. after <u>1</u> hours of pumping		

LOG DATA

TYPE OF LOG RUN (Circle One): No Log Run
 Electric, Gamma Ray, Density, Sonic, Neutron, Other (Describe) _____

Name of Organization Running Log _____

GEOLOGIC DATA (Office Use Only)

Surface Elev.	Geologic Unit	Unit Thickness	Depth to Top
Subs. SWL	Date	Analysis	Aquifer Test

Driller's Remarks

If more than one screen, show location of each on sketch.