

State Well Report

Part I

Mississippi Department of Environmental Quality
Office of Land and Water Resources
P.O. Box 10631
Jackson, MS 39289-0631
(601)961-5210
(601)354-6938 (fax)

County: Lincoln
Permit #: _____
Driller: GRENN WATER WELL & SUPPLY, INC.
Date drilling completed: 3/5/09

For Office Use Only:
Aquifer: _____
Well #: Q-102
L. S. Elevation: _____
E-log #: _____

State Law requires that this report be prepared by the driller in detail and filed with the Department within 30 days of completion of drilling of the well.

Well Owner Information	Well Location
Owner Name: <u>Hester Smith</u>	Latitude: <u>31.23.136</u> " Longitude: <u>90.37.923</u> " <small>08 55</small>
Mailing Address: <u>1118 Country Lake Dr</u>	Method of Lat/Long (circle one): Conventional Survey,
<u>Summit MS 39666</u>	USGS quad, <u>Hand-held GPS</u> , Survey-grade GPS
City State Zip Code	<u>SW 1/4 SW 20 Twn 5N Rng 6E</u>
Telephone No. <u>(601) 276-9088</u>	NW SW Direction Nearest Town Distance Direction of <u>10</u> Miles <u>SE</u> of <u>Lucien</u>

Well Data

Purpose of Well (circle one): Home Industrial Public Supply Irrigation Fish Culture Other: _____

Date well drilling started: 3/5/09 Date well drilling completed: 3/5/09

If flowing, method of flow regulation: Valve _____ Other (describe) _____

Static Water Level: 76 feet above or below (circle one) land surface Date measured: 3/5/09

Method of Measurement (circle one) steel tape electric tape air line other: _____

Hole depth: 101 Well depth: 99 Well grouted to a depth of 10 feet

Type of grout (circle one): Cement Bentonite Mix

Casing length: 89 feet Casing diameter: 4 inches Type of casing: PVC

Screen length: 10 feet Screen diameter: 4 inches Type of screen: PVC

Screen slot size: 20/10 inches Setting depth: From 89 feet to 99 feet

Type of completion (circle all applicable): Gravel packed Underreamed Telescoped Open hole Natural Development

Other (describe): _____

Top of lap pipe or reduction in casing: _____ feet. If telescoped or more than one screen, describe on back of page

Logs run (circle all applicable): No log run Electric Gamma Ray Density Sonic Neutron Other: _____

Name of organization running log(s): _____

I certify that the well was drilled, constructed, and completed in accordance with all applicable requirements of the Mississippi Department of Environmental Quality and/or the Mississippi Department of Health regulations and state laws.

GRENN WATER WELL & SUPPLY, INC.
Brian McClendon, lic. no. 0-664

Brian McClendon

Print Name of Water Well Contractor and License No.

Signature of Water Well Contractor

RECEIVED
APR 02 2009
BY: OLWR

If well telescopes please sketch below and show depths.


Q-102

Ground Level

Description of Formations Encountered	From	To
red clay	0	15
streaky	15	65
gravel	65	104

If more than one screen, show location of each on sketch

Sketch the property layout and include the following: 1) the well location; 2) any permanent structures on the property that may aid in locating the well; 3) any roads, power lines, or other items that may aid in locating the property and the well; 4) indicate direction.

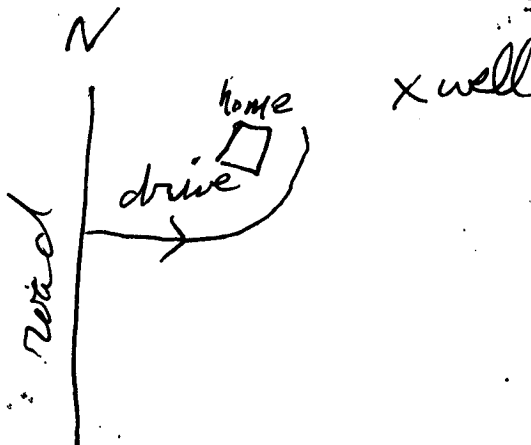

Landowner Name: Hester Smith

Brian McClendon
Signature of Water Well Contractor

Brian McClendon, lic. no. 0-664
GRENN WATER WELL & SUPPLY, INC.

STATE WELL REPORT

Part 2

Pump Installer's Completion Report
 Mississippi Department of Environmental Quality
 Office of Land and Water Resources
 P.O. Box 10631
 Jackson, MS 39289-0631
 (601)961-5210
 (601)354-6938 (fax)

For Office Use Only:

Aquifer: _____

Well #: Q-102

Elevation: _____

County: Lincoln
 Permit #: _____
 Driller: GRENN WATER WELL & SUPPLY, INC.
 Date completed: 3/7/09

This report should be prepared by the pump installer in detail and filed with the Department within 30 days of the installation of pump.

Well Owner Information	Well Location
Owner Name: <u>Hester Smith</u>	Latitude: <u>31°23'136"</u> Longitude: <u>90°37'923"</u>
Mailing Address: <u>1118 Country Lake Dr</u>	Method of Lat/Long (circle one): Conventional Survey, USGS quad, <u>Hand-held GPS</u> Survey-grade GPS
<u>Summit MS 39666</u> City State Zip Code	<u>SW ¼ SW ¼ Sec 20 Twn 5N Rng 6E</u>
Telephone No. <u>(601) 276-9088</u>	Distance Direction Nearest Town <u>10 Miles SE of Lucien</u>

Pump Type Circle one	Power Type Circle one
Air Lift Jet <input checked="" type="radio"/> <u>Submersible</u>	Diesel Engine Gasoline Engine Natural Gas
Bucket Piston Turbine	<input checked="" type="radio"/> <u>Electric Motor</u> Hand Tractor PTO
Centrifugal Rotary Flowing Well	Windmill Other (specify): _____
Other (specify): _____	Horse Power Rating of Motor: <u>1/2</u>
Date Pump Installed: <u>3/7/09</u>	Setting Depth: <u>90</u> feet
Rated Pump Capacity: <u>10</u> Gallons Per Minute	Number of Stages: <u>9</u>

Pump Test Data	Method of Measuring Water Level Circle one
Date Well Tested: <u>3/7/09</u>	Air Line <input checked="" type="radio"/> <u>Electric Measuring Line</u> Steel Tape
Static Water Level (A): <u>76</u> Feet Below Land Surface	Other (specify): _____
Pumping Water Level (B): <u>81</u> Feet Below Land Surface	For flowing well, measured shut in head: _____ feet
Drawdown [(B) - (A)]: <u>5</u> Feet Below Land Surface	Well yielded <u>11</u> GPM with a drawdown of <u>5</u> feet after <u>4</u> hours of pumping
Test Pumping Rate: <u>11</u> Gallons Per Minute	
Duration of Pump Test (minimum 4 hours): <u>4</u> hours	

I HEREBY CERTIFY that the above statements are true to the best of my knowledge.

GRENN WATER WELL & SUPPLY, INC.
WILLIAM L. HARDIN, LIC. NO. 0-802
 Print Name of Pump Installer and License No. (if applicable)

William Hardin
 Signature of Pump Installer

RECEIVED

APR 02 2009
 BY: OLWR