

State Well Report

Part 1

Mississippi Department of Environmental Quality
Office of Land and Water Resources
P.O. Box 10631
Jackson, MS 39289-0631
(601)961-5210
(601)354-6938 (fax)

For Office Use Only:

Aquifer: 0115
Well #: _____
L. S. Elevation: _____
E-log #: _____

County: Lincoln
Permit #: _____
Driller: GRENN WATER WELL & SUPPLY, INC.
Date drilling completed: 10/11/11

State Law requires that this report be prepared by the driller in detail and filed with the Department within 30 days of completion of drilling of the well.

Well Owner Information	Well Location
Owner Name: <u>Joe Buffington</u>	Latitude: <u>31° 23' 30"</u> Longitude: <u>90° 34' 48"</u>
Mailing Address: <u>1694 Blackberry Trl.</u>	Method of Lat/Long (circle one): Conventional Survey, ¹⁸ ₂₉
<u>Bogue Chitto, Ms. 39601</u>	USGS quad, <u>Hand-held GPS</u> , Survey-grade GPS
City State Zip Code	<u>SW 1/4 NE 1/4</u> Sec <u>23</u> Twn <u>5N</u> Rng <u>6E</u>
Telephone No. <u>(601) 695-9848</u>	SE NW Distance Direction Nearest Town <u>7</u> Miles <u>SW</u> of <u>Bogue Chitto</u>

Well Data

Purpose of Well (circle one) Home Industrial Public Supply Irrigation Fish Culture Other: _____

Date well drilling started: 10-11-11 Date well drilling completed: 10-11-11

If flowing, method of flow regulation: Valve _____ Other (describe) _____

Static Water Level: 61 feet above or below (circle one) land surface Date measured: 10-11-11

Method of Measurement (circle one) steel tape electric tape air line other: _____

Hole depth: 106 Well depth: 104 Well grouted to a depth of 10 feet

Type of grout (circle one): Cement Bentonite Mix

Casing length: 94 feet Casing diameter: 4 inches Type of casing: PVC

Screen length: 10 feet Screen diameter: 4 inches Type of screen: PVC

Screen slot size: .010 inches Setting depth: From 94 feet to 104 feet

Type of completion (circle all applicable): Gravel packed Underreamed Telescoped Open hole Natural Development
Other (describe): _____

Top of lap pipe or reduction in casing: _____ feet. If telescoped or more than one screen, describe on back of page

Logs run (circle all applicable): No log run Electric Gamma Ray Density Sonic Neutron Other: _____

Name of organization running log(s): _____

I certify that the well was drilled, constructed, and completed in accordance with all applicable requirements of the Mississippi Department of Environmental Quality and/or the Mississippi Department of Health regulations and state laws.

GRENN WATER WELL & SUPPLY, INC.
BRIAN D. McCLENDON, UNR-00000664

Brian McClelland
Signature of Water Well Contractor

Print Name of Water Well Contractor and License No.

RECEIVED
OCT 11 2011
STATE DEPARTMENT OF ENVIRONMENTAL QUALITY

Ø115


If well telescopes please sketch below and show depths.

Ground Level

Description of Formations Encountered	From	To
red clay	0	29
sand & clay streaks	29	60
sand & gravel	60	105
white clay	105	106

If more than one screen, show location of each on sketch

Sketch the property layout and include the following: 1) the well location; 2) any permanent structures on the property that may aid in locating the well; 3) any roads, power lines, or other items that may aid in locating the property and the well; 4) indicate direction.

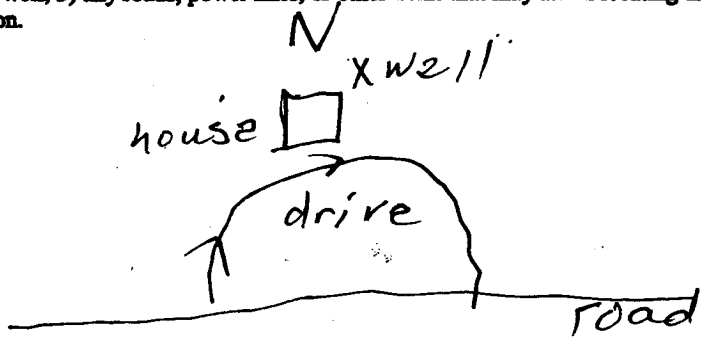

Landowner Name: Joe Buffington

Brian McClendon 664
 Signature of Water Well Contractor

STATE WELL REPORT

Part 2

Pump Installer's Completion Report
 Mississippi Department of Environmental Quality
 Office of Land and Water Resources
 P.O. Box 10631
 Jackson, MS 39289-0631
 (601)961-5210
 (601)354-6938 (fax)

County: Lincoln
 Permit #: _____
 Driller: GREENN WATER WELL & SUPPLY, INC.
 Date completed: 10-13-11

For Office Use Only:

Aquifer: _____
 Well #: Ø115
 Elevation: _____

This report should be prepared by the pump installer in detail and filed with the Department within 30 days of the installation of pump.

Well Owner Information	Well Location
Owner Name: <u>Joe Buffington</u>	Latitude: <u>31° 23' 300"</u> Longitude: <u>90° - 34' 484"</u>
Mailing Address: <u>1694 Blackberry Trl.</u>	Method of Lat/Long (circle one): Conventional Survey,
<u>Bogue Chitto, Ms. 39601</u>	USGS quad, <u>Hand-held GPS</u> , Survey-grade GPS
City State Zip Code	<u>SW ¼ NE ¼ Sec 23 Twn 5N Rng 6E</u>
Telephone No. <u>(601) 695-9848</u>	Distance <u>7</u> Miles Direction <u>SW</u> of Nearest Town <u>Roguechitto</u>

Pump Type Circle one	Power Type Circle one
Air Lift: Jet <input type="radio"/> <u>Submersible</u>	Diesel Engine <input type="radio"/> Gasoline Engine <input type="radio"/> Natural Gas <input type="radio"/>
Bucket: Piston <input type="radio"/> Turbine <input type="radio"/>	<u>Electric Motor</u> <input type="radio"/> Hand <input type="radio"/> Tractor PTO <input type="radio"/>
Centrifugal: Rotary <input type="radio"/> Flowing Well <input type="radio"/>	Windmill <input type="radio"/> Other (specify): _____
Other (specify): _____	Horse Power Rating of Motor: <u>1/2</u>
Date Pump Installed: <u>10-13-11</u>	Setting Depth: <u>81</u> feet
Rated Pump Capacity: <u>10</u> Gallons Per Minute	Number of Stages: <u>9</u>

Pump Test Data	Method of Measuring Water Level Circle one
Date Well Tested: <u>10-13-11</u>	Air Line <input type="radio"/> <u>Electric Measuring Line</u> <input type="radio"/> Steel Tape <input type="radio"/>
Static Water Level (A): <u>61</u> Feet Below Land Surface	Other (specify): _____
Pumping Water Level (B): <u>63</u> Feet Below Land Surface	For flowing well, measured shut in head: _____ feet
Drawdown [(B) - (A)]: <u>2</u> Feet Below Land Surface	Well yielded <u>11</u> GPM with a drawdown of
Test Pumping Rate: <u>11</u> Gallons Per Minute	<u>2</u> feet after <u>4</u> hours of pumping
Duration of Pump Test (minimum 4 hours): <u>4</u> hours	

I HEREBY CERTIFY that the above statements are true to the best of my knowledge.

MICHAEL W. KEES, RPO-00000801

Print Name of Pump Installer and License No. (if applicable)

Michael W. Kees
Signature of Pump Installer

RECEIVED
 OCT 27 2011
 ENVIRONMENTAL QUALITY