

Lincoln  
 \$ 2000  
 8-27-75

MISSISSIPPI  
 BOARD OF WATER COMMISSIONERS  
 416 North State Street  
 Jackson, Mississippi 39201  
 WATER WELL DRILLERS LOG


Aug. 27 1975 Grenn Water Well Lincoln  
 date well completed firm name county well located

LANDOWNER: George E. Allred	description of fomations encountered	from	to
Route 3, Box 150C Bogue Chitto, Miss. (mailing address)			
<b>WELL LOCATION:</b>			
sec. <u>23</u> T <u>5</u> <u>N</u> R. <u>6</u> <u>E</u> <sup>134</sup> S W			
<u>8</u> miles <u>SW</u> of <u>Bogue Chitto</u> (distance) (direction) (nearest town)			
<b>WELL PURPOSE:</b> home (home, irrigation, municipal, industrial)			
<b>WELL COMPLETION DATA:</b>			
(1) diameter (inches) <u>6"</u>			
(2) total depth (feet) <u>99</u>			
(3) static water level (feet) <u>69</u> below top of ground.			
(4) casing <u>PVC</u> <u>93'</u> (material) (depth) <u>410</u> If telescope see back. (size)			
(5) screen <u>6'</u> <u>93</u> (length) (depth to top) <u>.010</u> <u>PVC</u> (size) (material)			
(6) pump <u>did not install</u> (HP) (yield gpm)  (type power)			
(7) electric log <u>no</u> (yes or no)  (organization running log)			
(8) how well bottom plugged <u>wood</u>			
<b>DRILLERS REMARKS:</b>			

MISS. Bd. OF WATER COMMISSIONERS  
 1975

If well telescopes please sketch and show depths.

GROUND LEVEL

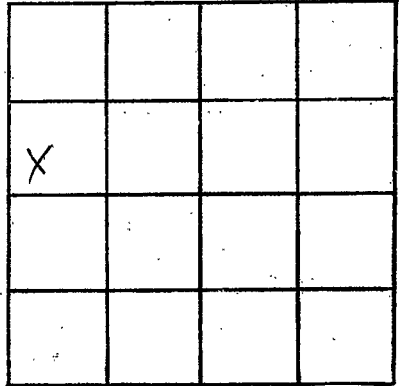

SECTION: 23

Please indicate well location X.

ADDITIONAL INFORMATION

If more than one screen, show locations of each on sketch.