

Lincoln  
 2001  
 4-16-76

MISSISSIPPI  
 BOARD OF WATER COMMISSIONERS  
 416 North State Street  
 Jackson, Mississippi 39201

WATER WELL DRILLERS LOG


April 16 1976 *Newman* Lincoln  
 date well completed firm name county well located

LANDOWNER:	description of formations encountered	from	to
<i>Lee Fairchild</i> <i>Rt. Bogre chitto</i> (mailing address)			
WELL LOCATION: sec <i>13</i> T <i>5</i> N R <i>6</i> E <i>5 1/2</i> miles <i>West</i> of <i>Northfield</i> (distance) (direction) (nearest town)			
WELL PURPOSE: <i>house</i> (home, irrigation, municipal, industrial)			
WELL COMPLETION DATA:			
(1) diameter (inches) <i>4"</i>			
(2) total depth (feet) <i>111</i>			
(3) static water level (feet) <i>68</i> below top of ground.			
(4) casing <i>plastic bottom</i> (material) (depth)			
<i>1</i> if telescope see back. (size)			
(5) screen <i>6'</i> <i>105'</i> (length) (depth to top)			
<i>1/2"</i> <i>plastic</i> (size) (material)			
(6) pump <del>1/2 HP</del> (HP) (yield gpm)			
<i>split</i> (type power)			
(7) electric log <i>no</i> (yes or no)			
<i>—</i> (organization running log)			
(8) how well bottom plugged <i>wooden plug</i>			
DRILLERS REMARKS: <i>new house</i>			

RECEIVED  
 JUL - 8 1976

If well telescopes, please sketch and show depths.

GROUND LEVEL

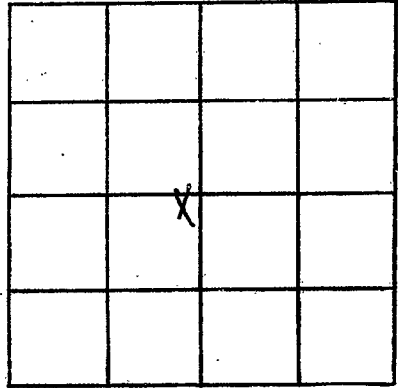

SECTION 3

Please indicate well location X.

ADDITIONAL INFORMATION

If more than one screen, show locations of each on sketch.