

Lincoln
 # 2002
 6-14-77

MISSISSIPPI
 BOARD OF WATER COMMISSIONERS
 416 North State Street
 Jackson, Mississippi 39201

WATER WELL DRILLERS LOG

June 14 1977 Covington Lincoln
 date well completed firm name county well located

LANDOWNER: CHARLES WOOD
 Rt # 3
 Bogoe Chitto
 (mailing address)

description of formations encountered	from	to
CLAY	0	45
SANDY CLAY	45	50
CLAY	50	60
SAND	60	72
SAND & ROCK	72	90

WELL LOCATION:
 sec. 23 T. 5 N R. 6 E
 12 miles n.n.w of Summit
 (distance) (direction) (nearest town)

WELL PURPOSE: Home
 (home, irrigation, municipal, industrial)


- WELL COMPLETION DATA:
- (1) diameter (inches) 4
 - (2) total depth (feet) 90
 - (3) static water level (feet) 65 below top of ground.
 - (4) casing PUFSEIC 80 (material) (depth)
 - 4 (size) if telescope see back.
 - (5) screen 10' 80 (length) (depth to top)
 - 4 PUFSEIC (size) (material)
 - (6) pump 1/2 HP 6 (yield gpm)
 - (type power)
 - (7) electric log (yes or no)
 - (organization running log)
 - (8) how well bottom plugged Wood

DRILLERS REMARKS:

RECEIVED
 AUG 10 1977

If well telescopes please sketch and show depths.

GROUND LEVEL

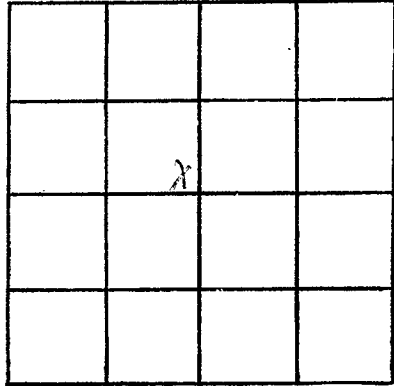

SECTION 23

Please indicate well location X.

ADDITIONAL INFORMATION

If more than one screen, show locations of each on sketch.