

Lincoln
 2054
 7/20/77

MISSISSIPPI
 BOARD OF WATER COMMISSIONERS
 416 North State Street
 146 Jackson, Mississippi 39201

WATER WELL DRILLERS LOG

July 20 1977 Covington Lincoln
 date well completed firm/name county well located

LANDOWNER: Versie Case
 Rt. 2 Smithdale
 Miss.
 (mailing address)

WELL LOCATION:
 sec. 9 T 5 N R 6 E
 15 miles N.W. of Summit
 (distance) (direction) (nearest town)

WELL PURPOSE: Home
 (home, irrigation, municipal, industrial)

WELL COMPLETION DATA:

(1) diameter (inches) 4

(2) total depth (feet) 80

(3) static water level (feet) 61 below top of ground.

(4) casing Plastic 70
 (material) (depth)
 4 If telescope see back.
 (size)

(5) screen 10 70
 (length) (depth to top)
 4 Plastic
 (size) (material)

(6) pump 1/2 8
 (HP) (yield gpm)

(type power)

(7) electric log (yes or no)

(organization running log)

(8) how well bottom plugged Wood

description of formations encountered	from	to
CLAY	0	18
SANDY CLAY	18	32
Red CLAY	32	61
SAND + GRAVEL	61	65
Lobolly SAND	65	71
SAND & ROCK	71	80


RECEIVED
 AUG 5 1977

DRILLERS REMARKS:

MISS. BD. OF WATER COMMISSIONERS

If well telescopes please sketch and show depths.

GROUND LEVEL

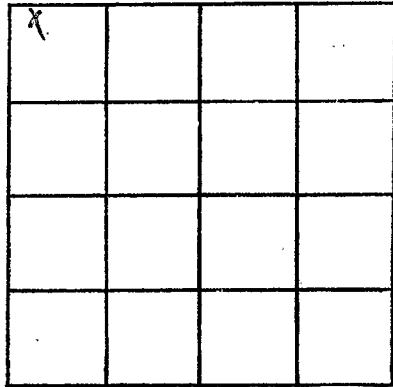

SECTION 9

Please indicate well location X.

ADDITIONAL INFORMATION

If more than one screen,
show locations of each on sketch.