

Lincoln
 # 2005
 7/30/77

MISSISSIPPI
 BOARD OF WATER COMMISSIONERS
 416 North State Street
 146 Jackson, Mississippi 39201

WATER WELL DRILLERS LOG

July 30 19 77 Covington Lincoln
 date well completed firm name county well located

LANDOWNER: J.B. Wilson
 Smithdale Miss
 Rt. #2
 (mailing address)

description of formations encountered	from	to
CLAY	0	27
SANDY CLAY	27	50
CLAY	50	55
SAND	55	80

WELL LOCATION:
 sec. 9 T. 5^N R. 6^E
 15 miles NW of Summit
 (distance) (direction) (nearest town)

WELL PURPOSE: Home
 (home, irrigation, municipal, industrial)

WELL COMPLETION DATA:

(1) diameter (inches) 1 1/2

(2) total depth (feet) 80

(3) static water level (feet) 52 below top of ground.

(4) casing IRON PIPE 70 (material) (depth)
 4 (size) if telescope see back.

(5) screen 10 70 (length) (depth to top)
 4 PLASTIC (size) (material)

(6) pump 1/2 8 (HP) (yield gpm)

(type power)

(7) electric log (yes or no)

(organization running log)

(8) how well bottom plugged Wood


DRILLERS REMARKS:

RECEIVED
 AUG 5 1977

MISS. BU. OF WATER CONTROL

If well telescopes please sketch and show depths.

GROUND LEVEL

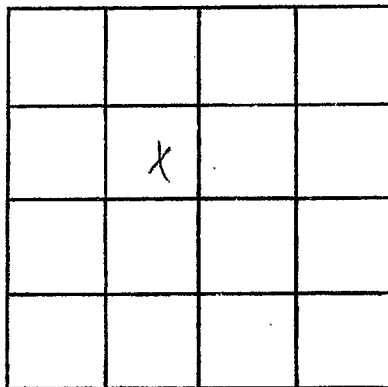

SECTION 9

Please indicate well location X.

ADDITIONAL INFORMATION

If more than one screen, show locations of each on sketch.