

Lincoln

111

<del>2006</del>
2006
8/22/77

MISSISSIPPI  
BOARD OF WATER COMMISSIONERS  
416 North State Street  
Jackson, Mississippi 39201

WATER WELL DRILLERS LOG


Aug 22 1977 Reuss Miller Lincoln  
date well completed firm name county well located

LANDOWNER:	description of formations encountered	from	to
Barnett Thompson Rt 3 Bogue Chitto (mailing address)			
WELL LOCATION: sec. <u>11</u> T- <u>5</u> N R- <u>6</u> E <u>1</u> miles <u>west</u> of <u>Ardmore</u> (distance) (direction) (nearest town)			
WELL PURPOSE: <u>Home</u> (home, irrigation, municipal, industrial)			
WELL COMPLETION DATA:			
(1) diameter (inches) <u>4"</u>			
(2) total depth (feet) <u>80'</u>			
(3) static water level (feet) <u>53</u> below top of ground.			
(4) casing <u>plastic bottom</u> (material) (depth)			
(size) if telescope see back.			
(5) screen <u>5'</u> <u>75'</u> (length) (depth to top)			
<u>4"</u> <u>plastic</u> (size) (material)			
(6) pump <u>1/2 hp</u> <u>10</u> (HP) (yield gpm)			
<u>slat</u> (type power)			
(7) electric log <u>no</u> (yes or no)			
(organization running log)			
(8) how well bottom plugged <u>wooden plug</u>			
DRILLERS REMARKS: <u>[Signature]</u>			

RECEIVED  
DEC 30 1977  
MISS. BD. OF WATER COMMISSIONERS

If well telescopes please sketch and show depths.

GROUND LEVEL

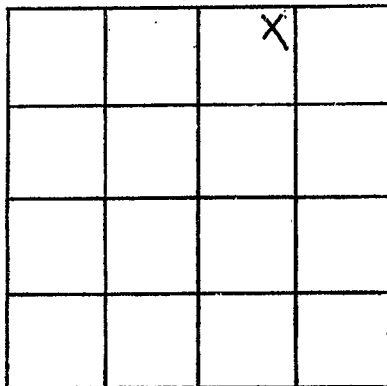

SECTION 11

Please indicate well location X.

ADDITIONAL INFORMATION

If more than one screen,  
show locations of each on sketch.