

LINCOLN

0
2007
1-6-78

MISSISSIPPI
BOARD OF WATER COMMISSIONERS
416 North State Street
Jackson, Mississippi 39201

WATER WELL DRILLERS LOG

LINCOLN

Lincoln
County

Jan 6 - 19 *78* *Perkins Miller*
date well completed firm name county well located

LANDOWNER:	description of formations encountered	from	to
<i>Percy Evans</i>	<i>Red Chalky clay</i>	<i>0</i>	<i>30</i>
<i>Wm B. Boogie Chitto</i> (mailing address)	<i>Red sand</i>	<i>30</i>	<i>47</i>
	<i>sand & gravel</i>	<i>47</i>	<i>96</i>
WELL LOCATION:			
sec. <i>24</i> T. <i>5</i> N R. <i>6</i> E			
<i>2 1/2</i> miles <i>South</i> of <i>Arlington</i>			
(distance) (direction) (nearest town)			
WELL PURPOSE: <i>house</i> (home, irrigation, municipal, industrial)			
WELL COMPLETION DATA:			
(1) diameter (inches) <i>4"</i>			
(2) total depth (feet) <i>96</i>			
(3) static water level (feet) <i>50</i> below above top of ground.			
(4) casing <i>plastic bottom</i> (material) (depth)			
<i>4</i> if telescope see back. (size)			
(5) screen <i>5'</i> , <i>91'</i> (length) (depth to top)			
<i>4"</i> , <i>plastic</i> (size) (material)			
(6) pump <i>1/2 HP</i> , <i>10</i> (HP) (yield gpm)			
<i>1/2</i> (type power)			
(7) electric log <i>no</i> (yes or no)			
(organization running log)			
(8) how well bottom plugged <i>weaken plug</i>			
DRILLERS REMARKS: <i>V</i>			


RECEIVED

MAY 11 1978

MISS. BO. OF WATER COMMISSIONERS

If well telescopes please sketch and show depths.

GROUND LEVEL

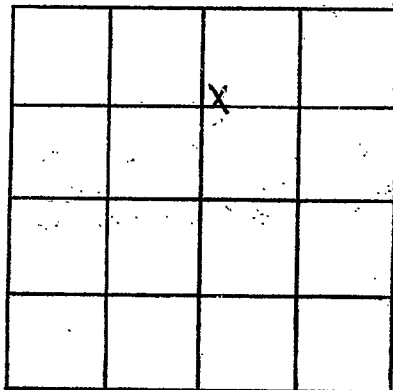

SECTION 24

Please indicate well location X.

ADDITIONAL INFORMATION

If more than one screen,
show locations of each on sketch.