

LINCOLN

Ø 2008

2/24/78

MISSISSIPPI  
 BOARD OF WATER COMMISSIONERS  
 416 North State Street  
 Jackson, Mississippi 39201

WATER WELL DRILLERS LOG

Feb. 24  
date well completed

1978 Bramfield Well Serv Lincoln  
firm name county well located

LANDOWNER: Walter MOAK  
Rt #2 Summit  
MISS  
 (mailing address)

description of formations encountered	from	to
<u>White clay</u>	<u>0</u>	<u>14</u>
<u>SAND</u>	<u>10</u>	<u>20</u>
<u>SAND &amp; BRN</u>	<u>20</u>	<u>57</u>

WELL LOCATION:

sec. 33 T-5 N R-6 E  
 S  
 (distance) miles (direction) of Hubert  
 (nearest town)

WELL PURPOSE: HOME  
 (home, irrigation, municipal, industrial)

WELL COMPLETION DATA:

- (1) diameter (inches) 1 1/2
- (2) total depth (feet) 51
- (3) static water level (feet) 16 below above top of ground.
- (4) casing PLASTIC 41  
 (material) (depth)  
4"  
 (size) if telescope see back.
- (5) screen 10 41  
 (length) (depth to top)  
4" PLASTIC  
 (size) (material)
- (6) pump 1/2 10  
 (HP) (yield gpm)  
Electric  
 (type power)
- (7) electric log NO  
 (yes or no)

(organization running log)

(8) how well bottom plugged Sandshank

DRILLERS REMARKS:


RECEIVED

MAR 21 1978

MISS. BD. OF WATER COMMISSIONERS

If well telescopes please sketch and show depths.

GROUND LEVEL

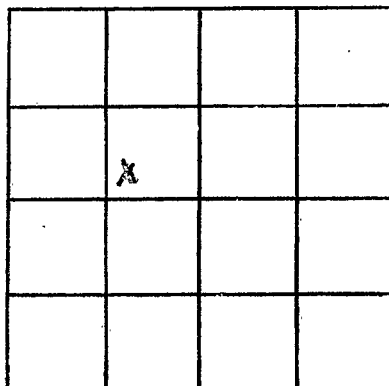

SECTION 33

Please indicate well location X.

ADDITIONAL INFORMATION

If more than one screen, show locations of each on sketch.