

Lincoln
 Q 2009
 3-1-79
 3-1

MISSISSIPPI
 BOARD OF WATER COMMISSIONERS
 416 North State Street
 Jackson, Mississippi 39201

WATER WELL DRILLERS LOG

19 79 Paternal Well Co Lincoln
 date well completed firm name county well located

LANDOWNER:
C. Wayne Johnson
P.O. Summit
 (mailing address)

| description of formations encountered | from | to |
|---------------------------------------|-----------------|-----------|
| | <u>Red clay</u> | <u>0</u> |
| <u>Red sand</u> | <u>20</u> | <u>70</u> |
| <u>Brace fault zone</u> | <u>70</u> | <u>86</u> |

WELL LOCATION:
 sec. 17 T S N 6 R E W
4 miles NW of Summit
 (distance) (direction) (nearest town)

WELL PURPOSE:
Home
 (home, irrigation, municipal, industrial)

WELL COMPLETION DATA:
 (1) diameter (inches) 4
 (2) total depth (feet) 86
 (3) static water level (feet) 62 below above top of ground.
 (4) casing PVC, 78,
 (material) (depth)
4 if telescope see back.
 (size)
 (5) screen 8, 78
 (length) (depth to top)
4, PVC
 (size) (material)
 (6) pump 1/2, 10
 (HP) (yield gpm)
Gas
 (type power)
 (7) electric log no
 (yes or no)
Paternal Well Co
 (organization running log)
 (8) how well bottom plugged Sand plug

Miss. Board of Water Comm


MAR 28 1979

RECEIVED

DRILLERS REMARKS:

If well telescopes please sketch and show depths.

GROUND LEVEL

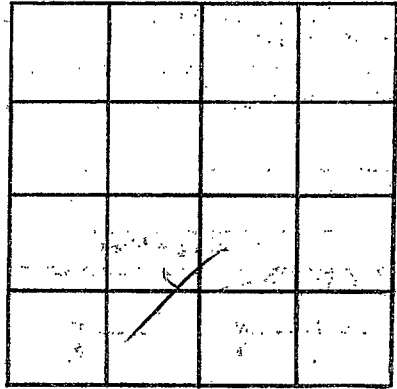

SECTION 17

Please indicate well location X.

ADDITIONAL INFORMATION

If more than one screen,
show locations of each on sketch.