

Lincoln  
 Q 2010  
 4-5-79

MISSISSIPPI  
 BOARD OF WATER COMMISSIONERS  
 416 North State Street  
 Jackson, Mississippi 39201

WATER WELL DRILLERS LOG

4-5 1979 Fitzgerald well Lincoln  
 date well completed firm name county well located

LANDOWNER:  
Harold King  
R.R. Bruce dills  
 (mailing address)

description of formations encountered	from	to
<u>Red clay</u>	<u>0</u>	<u>15</u>
<u>Coarse sand &amp; gravel</u>	<u>15</u>	<u>40</u>

WELL LOCATION:  
 sec. 1 T. 5 N. R. 6 E  
5 miles NE of Lebanon  
 (distance) (direction) (nearest town)

WELL PURPOSE:  
 (home, irrigation, municipal, industrial)

- WELL COMPLETION DATA:
- (1) diameter (inches) 4
  - (2) total depth (feet) 40
  - (3) static water level (feet) 25 below above top of ground.
  - (4) casing APC 32  
 (material) (depth)  
4 if telescope see back.  
 (size)
  - (5) screen 8 32  
 (length) (depth to top)  
4 APC  
 (size) (material)
  - (6) pump 1/2 10  
 (HP) (yield gpm)  
Electric  
 (type power)
  - (7) electric log no  
 (yes or no)
  - (organization running log)
  - (8) how well bottom plugged Sealed

DRILLERS REMARKS:


Miss. Board of Water Comm.

MAY 30 1979

RECEIVED

If well telescopes please sketch and show depths.

GROUND LEVEL

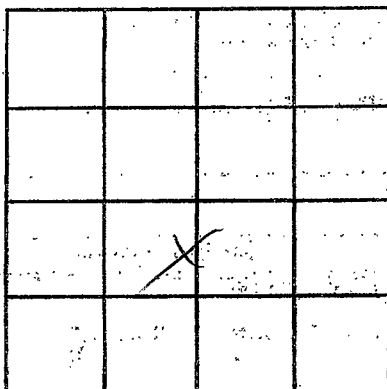

SECTION

Please indicate well location X.

ADDITIONAL INFORMATION

If more than one screen, show locations of each on sketch.