

Lincoln
Q 2011
4-30-80

MISSISSIPPI
 BOARD OF WATER COMMISSIONERS
 416 North State Street
 Jackson, Mississippi 39201

WATER WELL DRILLERS LOG

4-30 ¹⁹80 F. Samuel Well Co. Lincoln
 date well completed firm name county well located

LANDOWNER:

Howard Clay

B.B. Summit
 (mailing address)

WELL LOCATION:

sec. 35 T 5 N R 6 E
 S W
6 miles W of Summit
 (distance) (direction) (nearest town)

WELL PURPOSE: Home
 (home, irrigation, municipal, industrial)

WELL COMPLETION DATA:

- (1) diameter (inches) 4
- (2) total depth (feet) 115
- (3) static water level (feet) 55 below above top of ground.
- (4) casing 4 97
 (material) (depth)
4 If telescope see back.
 (size)
- (5) screen 8 97
 (length) (depth to top)
4 4
 (size) (material)
- (6) pump 1/2 10
 (HP) (yield gpm)
ele
 (type power)
- (7) electric log no
 (yes or no)
 (organization running log)
- (8) how well bottom plugged 3/4

description of formations encountered

from to

description of formations encountered	from	to
<u>Red Clay</u>	<u>0</u>	<u>20</u>
<u>Red Sand</u>	<u>20</u>	<u>50</u>
<u>White Chalk</u>	<u>50</u>	<u>105</u>
<u>Coarse Sand & gravel</u>	<u>105</u>	<u>115</u>

DRILLERS REMARKS:


DEPT. OF NATURAL RESOURCES
 BUREAU OF LAND & WATER RESOURCES

JUN 20 1980

RECEIVED

If well telescopes please sketch and show depths.

GROUND LEVEL

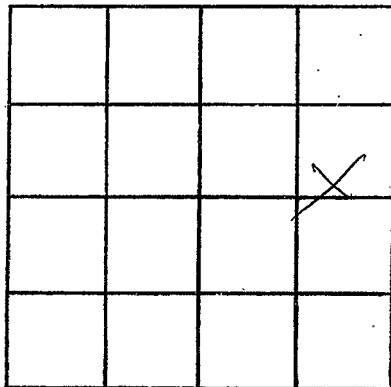

SECTION 35

Please indicate well location X.

ADDITIONAL INFORMATION

If more than one screen,
show locations of each on sketch.