

LINCOLN

0 2012

4/18/78

MISSISSIPPI BOARD OF WATER COMMISSIONERS
416 North State Street
Jackson, Mississippi 39201

WATER WELL DRILLERS LOG

April 18 1978 Reeves Well Drilling Lincoln
date well completed firm name county well located

LANDOWNER:
Mittie Tobias
P.O. Summit
(mailing address)

description of formations encountered	from	to
Red clay	0	22
Red Chalk	20	60
lumpy sand	60	90
sand & gravel	90	120

WELL LOCATION:
sec. 14 T-5 N R-6 E
6 miles N-NW of Summit
(distance) (direction) (nearest town)

WELL PURPOSE: Home
(home, irrigation, municipal, industrial)

WELL COMPLETION DATA:

(1) diameter (inches) 4"

(2) total depth (feet) 120'

(3) static water level (feet) 60 below top of ground

(4) casing plastic bottom (material) (depth)

(5) screen 5' 115' (length) (depth to top)

4" plastic (size) (material)

(6) pump beatrus (HP) (yield gpm)

shot (type power)

(7) electric log no (yes or no)

(organization running log)

(8) how well bottom plugged
wooden plug

DRILLERS REMARKS:


Miss. Board of Water Comm.

AUG 21 1978

RECEIVED

If well telescopes please sketch and show depths.

GROUND LEVEL

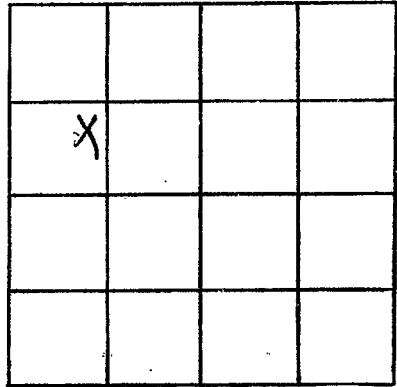

SECTION 14

Please indicate well location X.

ADDITIONAL INFORMATION

If more than one screen,
show locations of each on sketch.