

Lincoln
02013
9-7-79

MISSISSIPPI
 BOARD OF WATER COMMISSIONERS
 416 North State Street
 Jackson, Mississippi 39201

WATER WELL DRILLERS LOG

Lincoln
Miss

9-7 1979 Phyllis Hill Ltd Miss
 date well completed firm name county well located

LANDOWNER:
Tuff Carson
R.R. Summit, Miss.
 (mailing address)

description of formations encountered	from	to
<u>Red Clay</u>	<u>0</u>	<u>20</u>
<u>Red Sand</u>	<u>20</u>	<u>40</u>
<u>White Chalk</u>	<u>40</u>	<u>155</u>
<u>Gravel Sand</u>	<u>155</u>	<u>166</u>

WELL LOCATION:
 sec. 35 T. 5 N. R. 6 E.
8 miles WNW of Summit
 (distance) (direction) (nearest town)

WELL PURPOSE: Flow
 (home, irrigation, municipal, industrial)

- WELL COMPLETION DATA:
- (1) diameter (inches) 4
 - (2) total depth (feet) 166
 - (3) static water level (feet) 60 below top of ground.
 - (4) casing PVC, 158
 (material) (depth)
4 if telescope see back.
 (size)
 - (5) screen 8 158
 (length) (depth to top)
4 PVC
 (size) (material)
 - (6) pump 1/2 10
 (HP) (yield gpm)
1/2
 (type power)
 - (7) electric log no
 (yes or no)
no
 (organization running log)
 - (8) how well bottom plugged Seal top

DRILLERS REMARKS:


Miss. Board of Water Commissioners

SEP 12 1979

RECEIVED

If well telescopes please sketch and show depths.

GROUND LEVEL

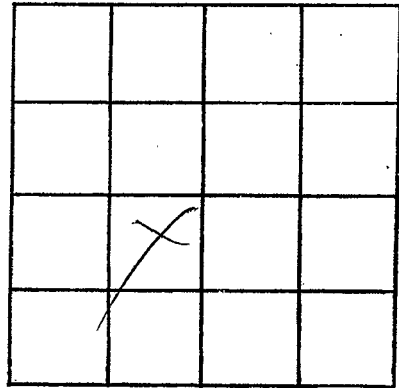

SECTION 35

Please indicate well location X.

ADDITIONAL INFORMATION

If more than one screen, show locations of each on sketch.