

Lines In
02014
9-27-79

MISSISSIPPI
 BOARD OF WATER COMMISSIONERS
 416 North State Street
 Jackson, Mississippi 39201

WATER WELL DRILLERS LOG

Sept. 27 1979 Grenn Water Well Cont. Lincoln
 date well completed firm name county well located

LANDOWNER: B. J. Gammill	description of formations encountered	from	to
Route 1			
MCCall Creek, Ms. (mailing address)			
WELL LOCATION: sec. <u>5</u> T. <u>5N</u> R. <u>6E</u> <u>12</u> miles <u>W</u> of <u>Bogue Chitto</u> (distance) (direction) (nearest town)			
WELL PURPOSE: <u>home</u> (home, irrigation, municipal, industrial)			
WELL COMPLETION DATA:			
(1) diameter (inches) <u>6</u>			
(2) total depth (feet) <u>110</u>			
(3) static water level (feet) <u>80</u> below top of ground.			
(4) casing <u>PVC</u> <u>100'</u> (material) (depth) <u>4"</u> (size) if telescope see back.			
(5) screen <u>10'</u> <u>100'</u> (length) (depth to top) <u>.010</u> <u>PVC</u> (size) (material)			
(6) pump <u>did not install</u> (HP) (yield gpm) (type power)			
(7) electric log <u>no</u> (yes or no) (organization running log)			
(8) how well bottom plugged <u>back wash valve</u>			
DRILLERS REMARKS:			


DEPT. OF NATURAL RESOURCES
 BUREAU OF LAND & WATER RESOURCES

NOV 20 1979

RECEIVED

If well telescopes please sketch and show depths.

GROUND LEVEL

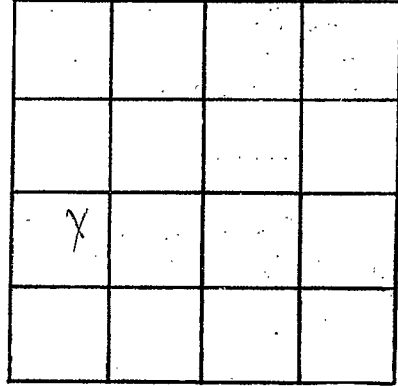

SECTION 5

Please indicate well location X:

ADDITIONAL INFORMATION

If more than one screen, show locations of each on sketch.