

MISSISSIPPI DEPARTMENT OF NATURAL RESOURCES

Bureau of Land and Water Resources

Southport Mall

P.O. Box 10631

Jackson, Mississippi 39209

WATER WELL DRILLERS LOG

Lincoln
Q 2016
2-20-81

Feb. 20 1981 Acorns well in Lincoln
 date well completed firm name county well located

LANDOWNER:	description of formations encountered	from	to
<p><u>David Alred</u> <u>Rt. 2 Smithdale</u> (mailing address)</p>	<p><u>Red clay</u> <u>Red sand</u> <u>small gravel & sand</u></p>	<p><u>18</u> <u>72</u> <u>72</u></p>	<p><u>18</u> <u>92</u> <u>95</u></p>
WELL LOCATION:			
<p>sec. <u>8</u> T. <u>5</u> N R. <u>6</u> E <u>3 1/2</u> miles <u>north</u> of <u>Acorns</u> (distance) (direction) (nearest town)</p>			
WELL PURPOSE:			
<p><u>Trailer</u> (home, irrigation, municipal, industrial)</p>			
WELL COMPLETION DATA:			
(1) diameter (inches) <u>4"</u>			
(2) total depth (feet) <u>95</u>			
(3) static water level (feet) <u>68</u> below above top of ground.			
(4) casing <u>plastic bottom</u> (material) (depth)			
_____ if telescope see back. (size)			
(5) screen <u>5'</u> <u>90</u> (length) (depth to top)			
(6) pump <u>4"</u> <u>plastic</u> (size) (material)			
(6) pump <u>by others</u> (HP) (yield gpm)			
(7) electric log <u>elect</u> (type power)			
(7) electric log <u>no</u> (yes or no)			
_____ (organization running log)			
(8) how well bottom plugged <u>Back Wash</u>			
DRILLERS REMARKS:			


DEPT. OF NATURAL RESOURCES
 BUREAU OF LAND & WATER RESOURCES

JUL 27 1981

RECEIVED

If well telescopes please sketch and show depths.

GROUND LEVEL

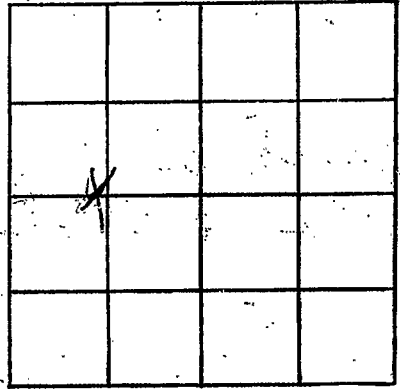

SECTION 8

Please indicate well location X.

ADDITIONAL INFORMATION

If more than one screen, show locations of each on sketch.